


















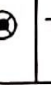
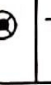













MAKE OF COMPONENTS

ACB	-	L&T
MCCB	-	L&T
CONTACTOR	-	L&T
METERS	-	CONZERV
IND.LAMP (LED TYPE)	-	ESBEE
CT	-	KAPPA
MCB	-	L&T
APFC RELAY	-	L&T
FUSE (HRC)	-	L&T

NOTES

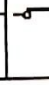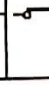- PANEL SHALL BE FABRICATED MADE OUT OF 2mm THICK CRCA SHEET STEEL, GLAND PALTE 3mm
- BASE FRAME SHALL BE 100x50x5mm 'C' TYPE CHANNEL
- PANELS SHALL BE FREE STANDING FLOOR MTG. TYPE DUST & VERMIN PROOF CONSTRUCTION
- SYNTHETIC (XLPE) RUBBER GASKET SHALL BE PROVIDED INSIDE THE DOOR TO MAKE THE PANEL DUST & VERMIN PROOF.
- BUS BAR SHALL BE OF ELECTROLYTIC GRADE ALUMINIUM
- BUSBAR SHALL BE INSULATED WITH HEAT SHRINKABLE PVC SLEEVES COLOUR CODED
- A CONTINUOUS EARTH BUS OF 25x5mm AL SHALL RUN AT BOTTOM
- PANEL FRONT DOOR SHALL BE PROVIDED WITH DOOR LOCK.
- ALL CABLE ENTRIES SHALL BE FROM BOTTOM
- THE PANEL SHALL BE PRE-TREATED WITH SEVEN TANK PROCESS (DEGREASING, DERUSTING PHOSPHATING PASSIVATION) BEFORE THE APPLICATION OF POWDER COATING.
- THE PANEL SHALL BE PAINTED WITH ELECTRO STATIC POWDER COATING PAINT
- DOORS/COVERS, SIDES, PARTITION PLATES
 - SIEMENS GREY (RAL 7032)
 - SIEMENS GREY/ELECTRO GALVANISED. SHEET
 - DARK BLUE
 - BLACK.
- BASE FRAME
- ALL HINGED DOORS SHALL BE EARTHED THROUGH 2.5sqmm COPPER FLEXIBLE WIRE
- CONTROL WIRING SHALL BE CARRIED OUT WITH 1100V GRADE PVC INSULATED COPPER FLEXIBLE WIRE OF FOLLOWING SIZES & COLOUR STANDARD.
 - A. AC VOLTAGE CIRCUIT - 2.5 Sqmm BLACK
 - B. CURRENT CIRCUIT - 2.5 Sqmm RED, YELLOW, BLUE & BLACK
 - C. CONTROL CIRCUIT
 - 2.5 Sqmm BLACK
 - 2.5 Sqmm BLACK
 - 2.5 Sqmm GREY
 - D. DC CIRCUIT (24V, DC)
 - E. POWER CIRCUIT - SIZES AS PER CURRENT RATING RED, YELLOW, BLUE & BLACK
 - F. INTER PANEL & PLC WIR. - 1.0 Sqmm BLACK

SYMBOLS

SYMBOL	DESCRIPTION	S.No.	SYMBOL	DESCRIPTION	SYMBOL	DESCRIPTION
	MCCB/SW			O/L RELAY		LIFTING HOOKS
	HANDLE			NC CONTACT OF		EARTHING STRIP
	AMMETER			STOP PUSH BUTTON		CAPACITOR
	VOLTMETER			START PUSH BUTTON		TOGGLE SW
	SELECTOR SWITCH			NEUTRAL LINK		
	PUSH BUTTON			TERMINAL		
	INDICATING LIGHT			CHANGE OVER SWITCH		
	IND. LIGHT WITH P.B			C. T.		
	MCCB/ACB			CONTACTOR		
	FSU/SFU/SDFU			CONTACTOR COIL		
	MCB			TIMER		
	HRC FUSE			TIMER OPEN ON DELAY		
	NC CONTACT			TIMER CLOSED ON DELAY		
	NO CONTACT			STAR DELTA TIMER		

A

B

C

D

E

F

G

	AMMETER		STOP PUSH BUTTON		CAPACITOR
	VOLTMETER		START PUSH BUTTON		TOGGLE SW
	SELECTOR SWITCH		NEUTRAL LINK		
	PUSH BUTTON		TERMINAL		
	INDICATING LIGHT		CHANGE OVER SWITCH		
	IND. LIGHT WITH P.B		C. T.		
	MCCB/ACB		CONTACTOR		
	FSU/SFU/SDFU		CONTACTOR COIL		
	MCB		TIMER		
	HRC FUSE		TIMER OPEN ON DELAY		
	NC CONTACT		TIMER CLOSED ON DELAY		
	NO CONTACT		STAR DELTA TIMER		

LEGENDS

C

D

E


F

G

33 KV NAVLAKHA FEEDER

33 KV RAJENDRA NAGAR FEEDER

UGC -DAE CSR ELECTRICAL SCHEME (SL)

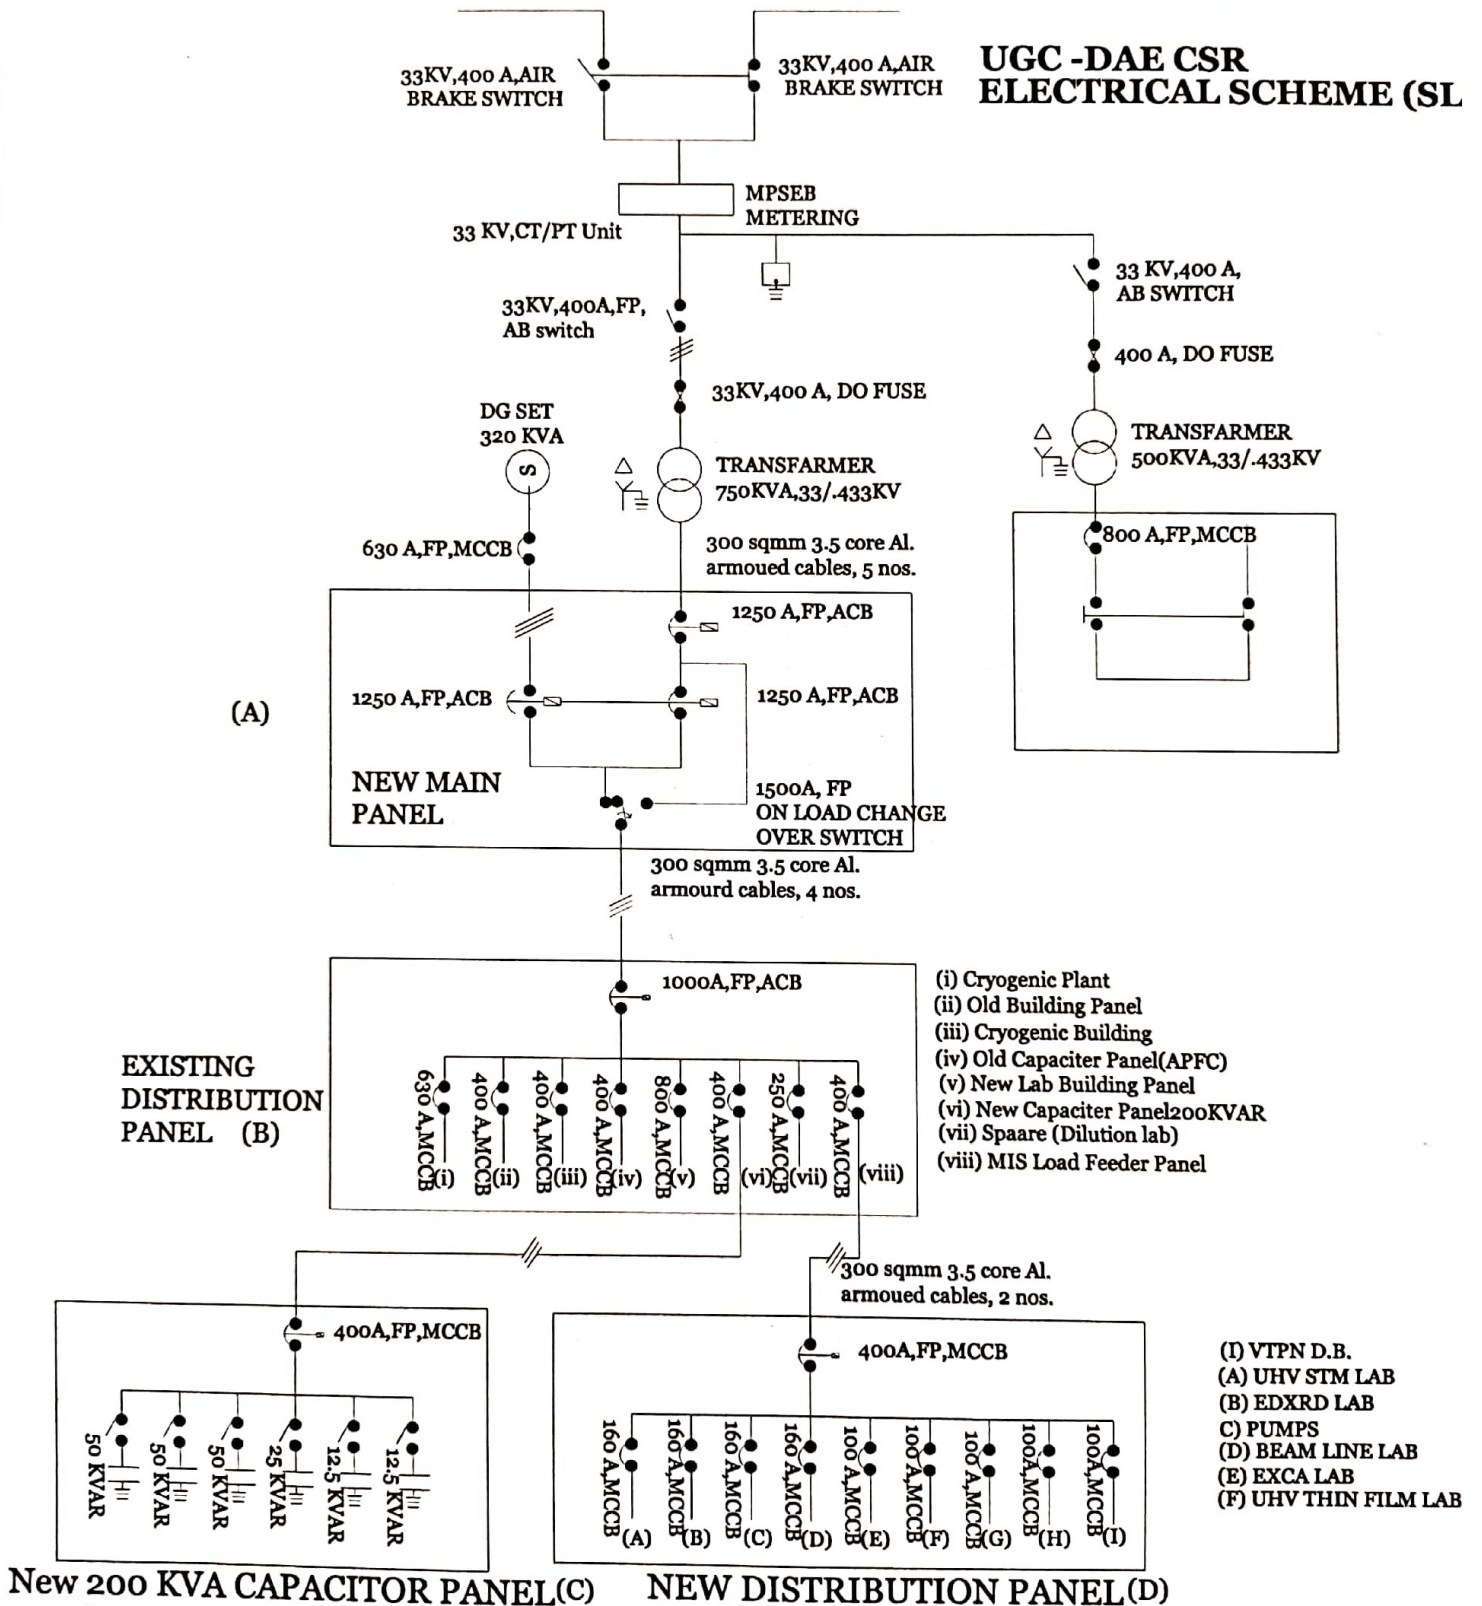


EXISTING DISTRIBUTION PANEL (B)

NEW MAIN PANEL (A)

NEW 200 KVA CAPACITOR PANEL (C)

NEW DISTRIBUTION PANEL (D)

- (I) VTPN D.B.
- (A) UHV STM LAB
- (B) EDXRD LAB
- (C) PUMPS
- (D) BEAM LINE LAB
- (E) EXCA LAB
- (F) UHV THIN FILM LAB
- (i) Cryogenic Plant
- (ii) Old Building Panel
- (iii) Cryogenic Building
- (iv) Old Capacitor Panel (APFC)
- (v) New Lab Building Panel
- (vi) New Capacitor Panel 200KVAR
- (vii) Spare (Dilution lab)
- (viii) MIS Load Feeder Panel

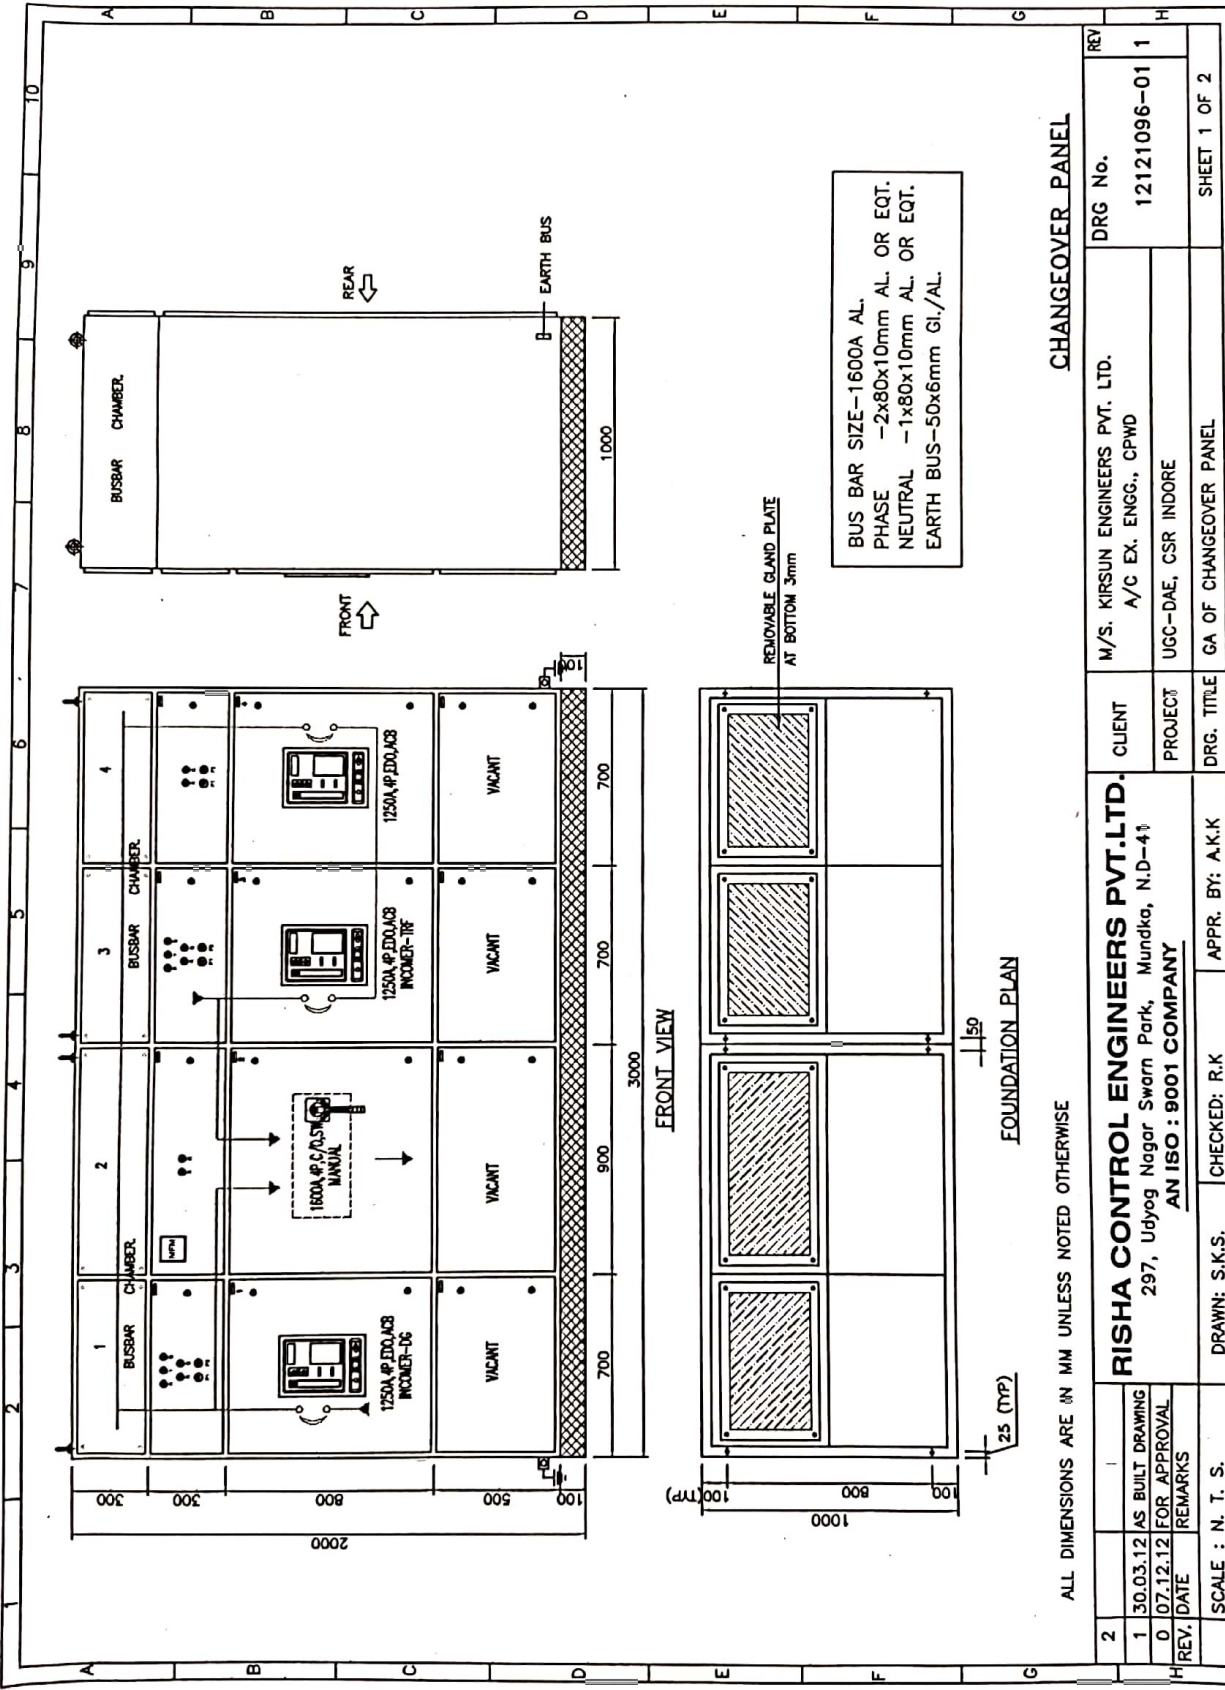


CHANGEOVER PANEL


ALL DIMENSIONS ARE IN MM UNLESS NOTED OTHERWISE

2	1	REV	CHANGEOVER PANEL	
1	30.03.12 AS BUILT DRAWING	DRG No.	M/S. KIRSUN ENGINEERS PVT. LTD.	12121096-01 1
0	07.12.12 FOR APPROVAL	CLIENT	A/C EX. ENGG., CPWD	
	REMARKS	PROJECT	UGC-DAE, CSR INDORE	
	SCALE : N. T. S.	DRG. TITLE	GA OF CHANGEOVER PANEL	SHEET 1 OF 2
		CHECKED: R.K	APPR. BY: A.K.K	
		DRAWN: S.K.S.		

RISHA CONTROL ENGINEERS PVT.LTD.
 297, Udyog Nagar Swarn Park, Mundka, N.D-41
 AN ISO : 9001 COMPANY

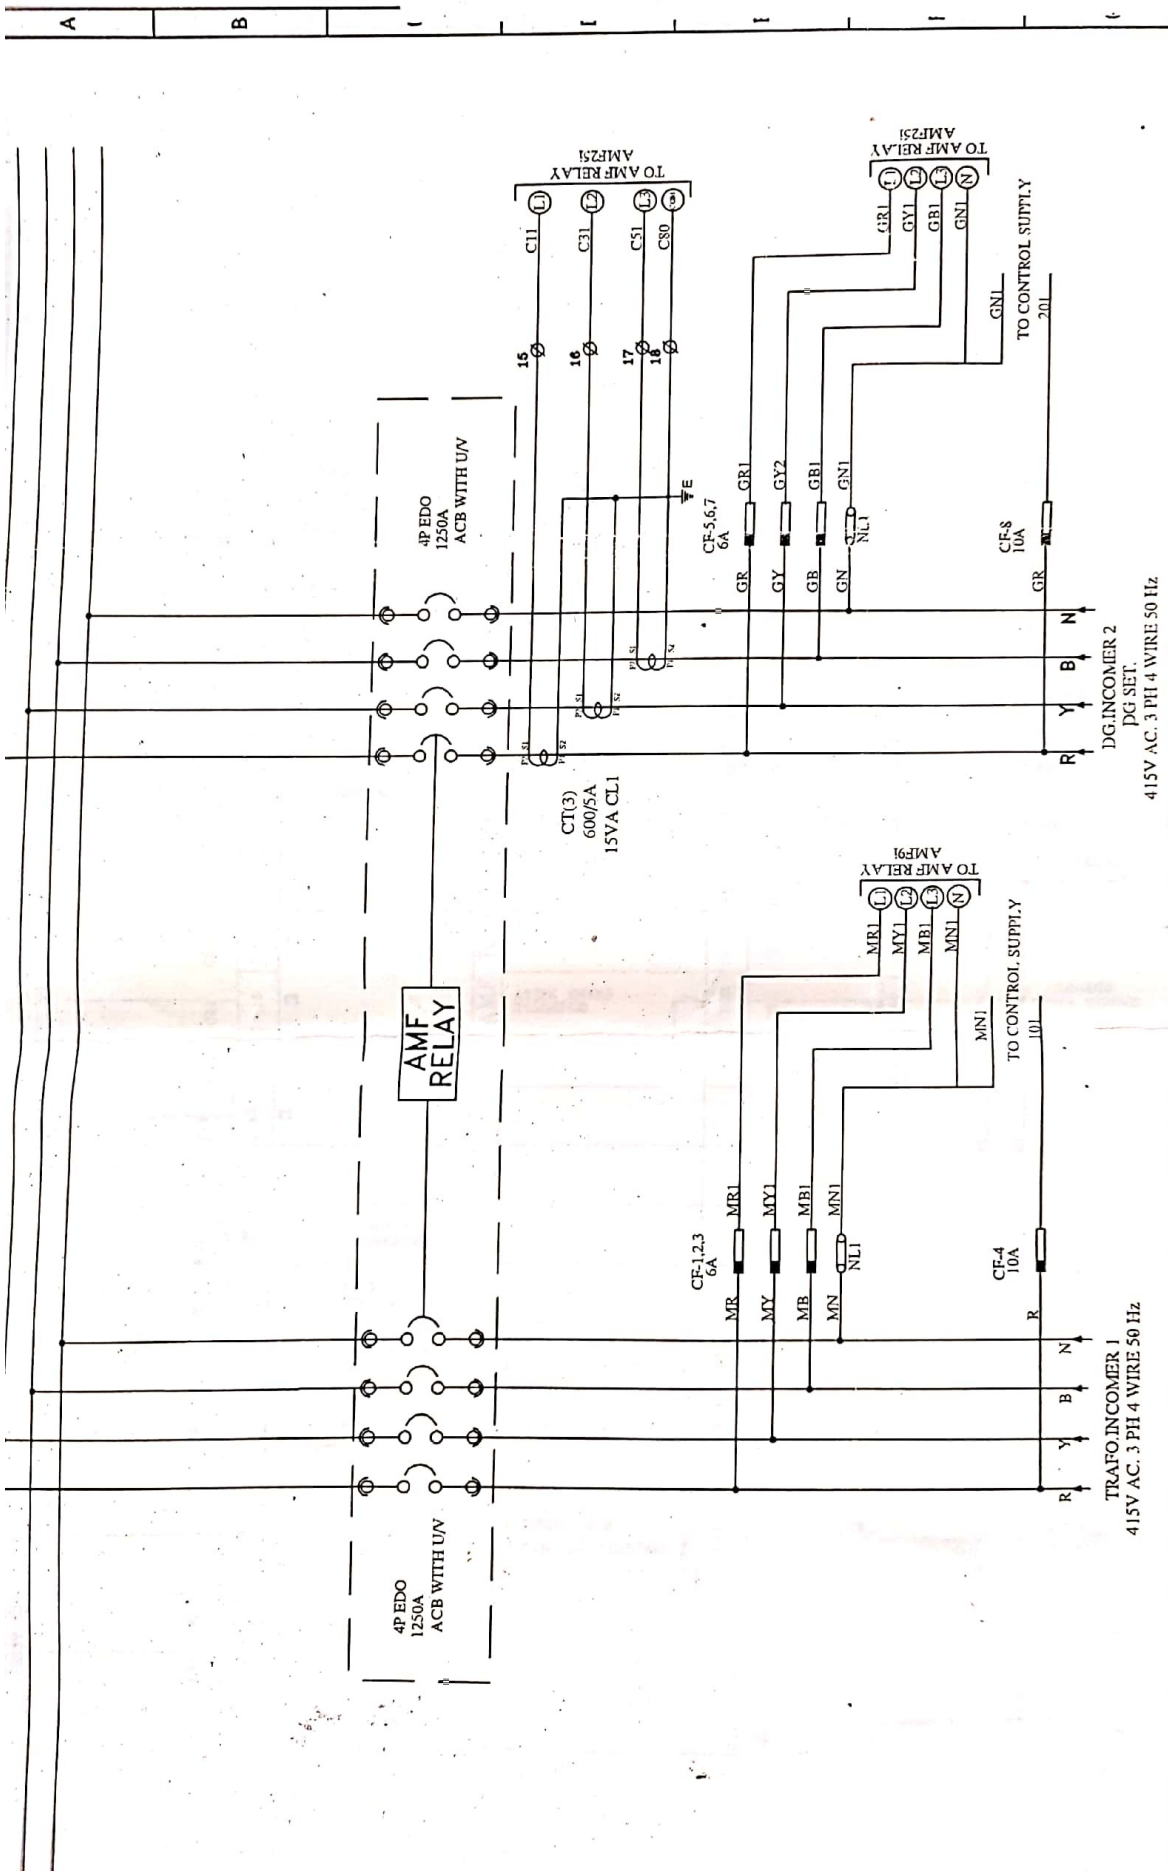

ISSUED FOR INFORMATION		DESCRIPTION		2	3	4	5	6	7	8
DRWN	CHKD	APPD	DATE	SCALE	N/TS	PLANT :-				
BY	BY	BY	17/05/14			CLIENT:- CPWD INDORE				
						PLANT:-				
						TITLE:- AMF PANEL				
						O.C.N.O.		DIRG.NO.		REV.NO.
						CPWI/4533		CPWI/4533		01 OF 05
										00
TRAFO.INCOMER 1		415V AC. 3 PH 4 WIRE 50 Hz				DG.INCOMER 2		415V AC. 3 PH 4 WIRE 50 Hz		
AMF RELAY		CT(3) 600/5A 15VA CL1				CF-5,6,7 6A		CF-8 10A		
4P EDO 1250A ACB WITH UV		4P EDO 1250A ACB WITH UV				GR		GR		
R Y B N		R Y B N				R Y B N		R Y B N		

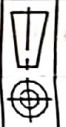

INDIPTON ELECTRONICS
 PRACTICAL QUALITY SERVICE

CAD FILE NO.
 DWG_ID_CPWI_1414_3

INDIPTON

INDIPTON ELECTRONICS
 PRACTICAL QUALITY SERVICE

CAD FILE NO.
 DWG_ID_CPWI_1414_3



INDIPTON ELECTRONICS
 PRACTICAL QUALITY SERVICE


INDIPTON

INDIPTON ELECTRONICS
 PRACTICAL QUALITY SERVICE

CAD FILE NO.
 DWG_ID_CPWI_1414_3

INDIPTON

INDIPTON ELECTRONICS
 PRACTICAL QUALITY SERVICE

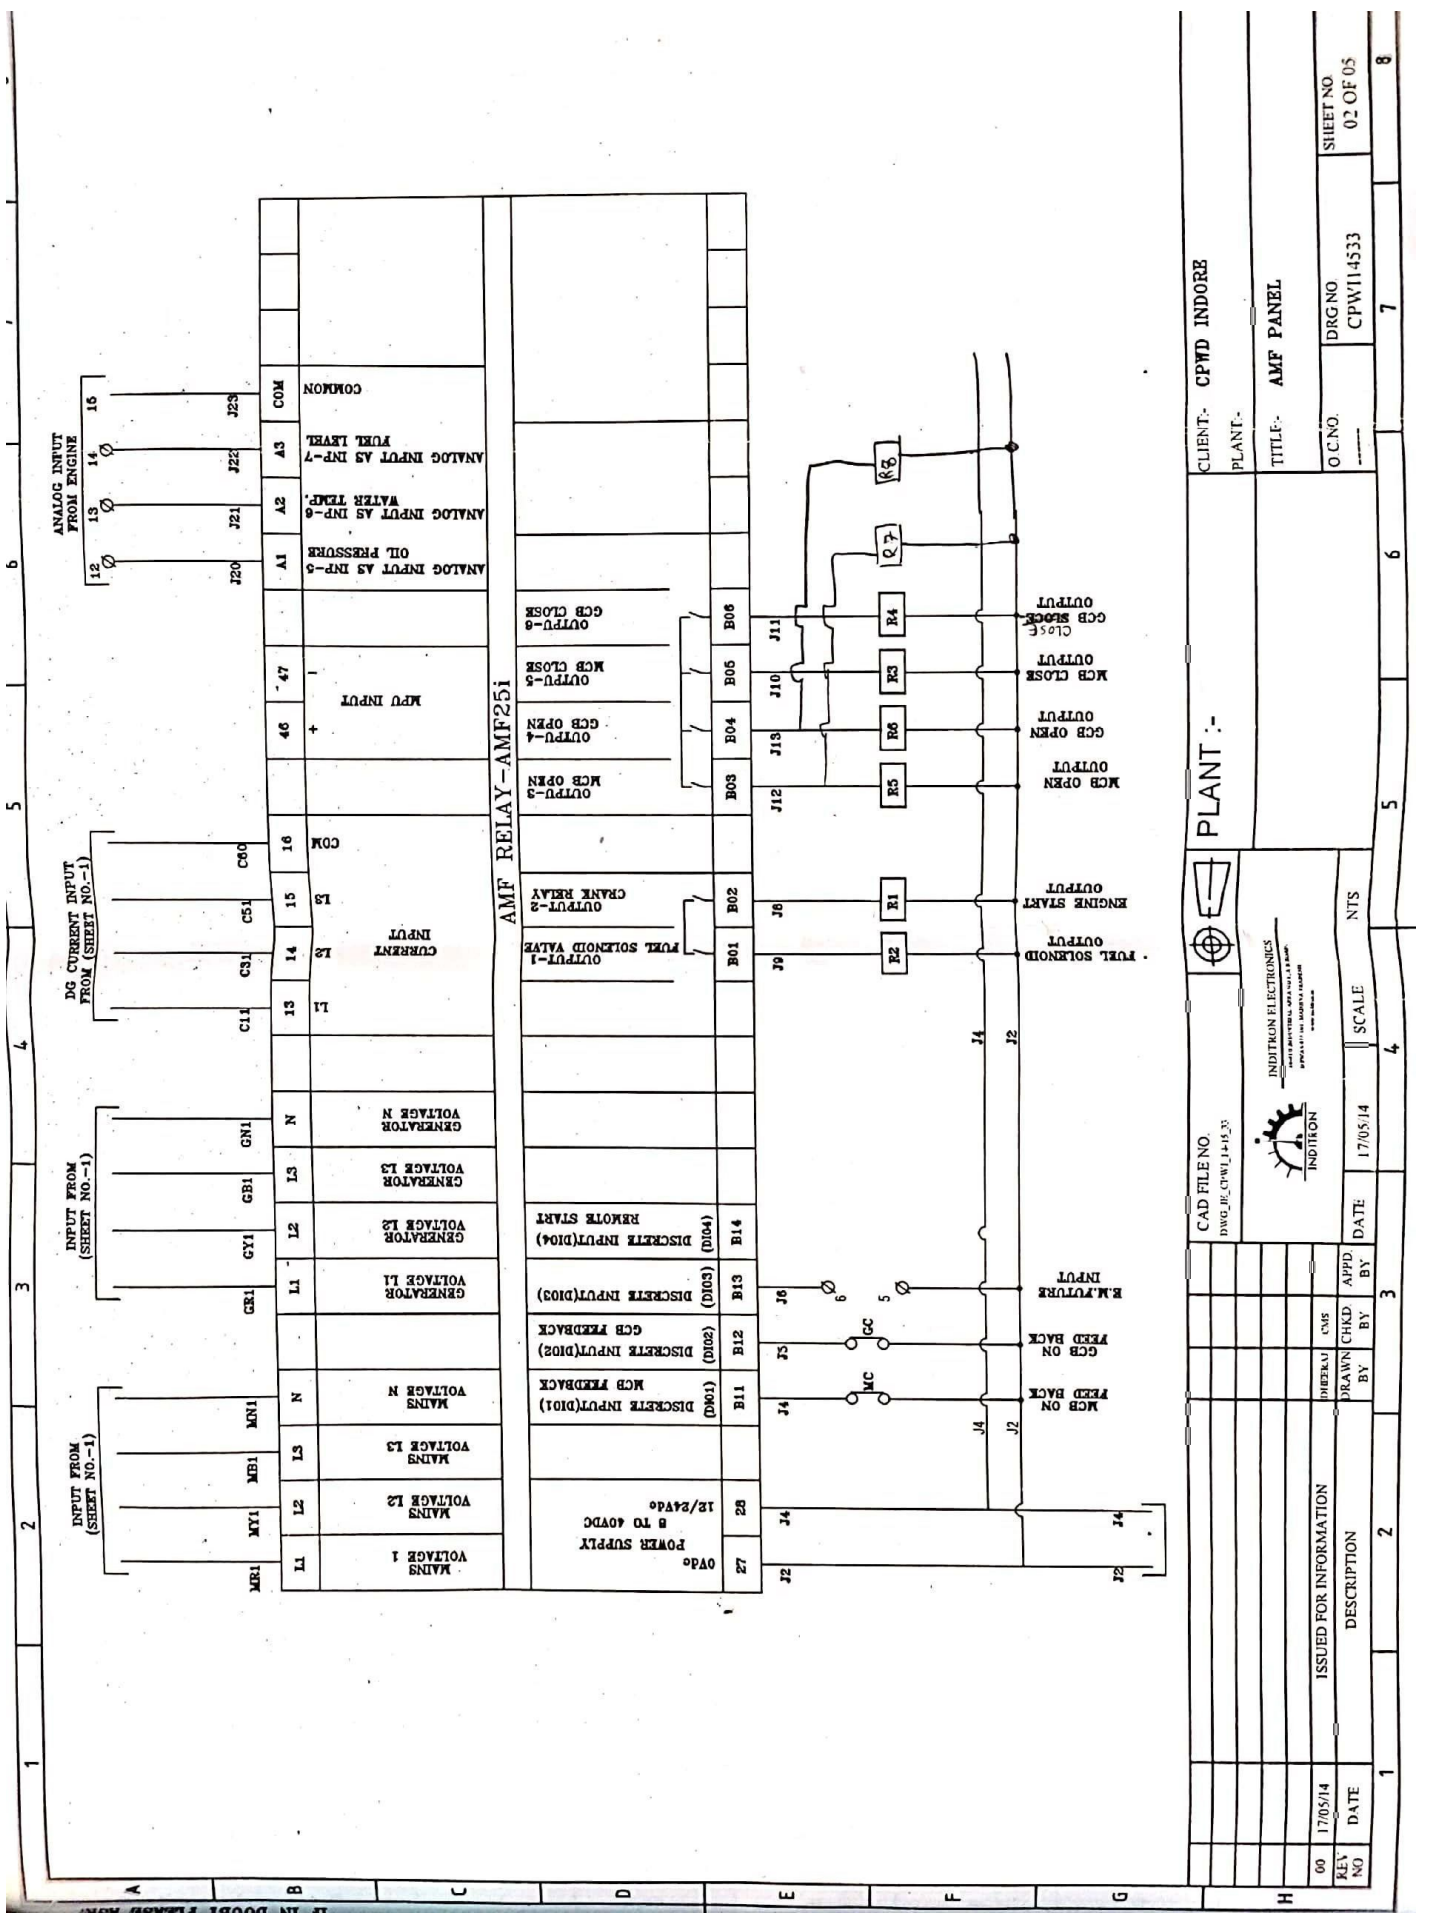


Terminal	Description	Terminal	Description
J27	POWER SUPPLY 12/24Vdc 5 TO 40Vdc	J20	ANALOG INPUT AS IMP-3 OIL PRESSURE
J28		J21	ANALOG INPUT AS IMP-6 WATER TEMP.
J29		J22	ANALOG INPUT AS IMP-7 FUEL LEVEL
J30		J23	COMMON
J31			
J32			
J33			
J150			


AMF RELAY - AMF25i

Terminal	Description
J27	POWER SUPPLY 12/24Vdc 5 TO 40Vdc
J28	
J29	
J30	
J150	

CLIENT:- CPWD INDORE		PLANT:-	
TITLE:- AMF PANEL		O.C.NO. CPW114533	
DRG NO		SHEET NO	
17/05/14		02 OF 05	
ISSUED FOR INFORMATION			
REV NO	DATE	DESCRIPTION	
00	17/05/14		
DRAWN BY		SCALE	
CHKD BY		DATE	
APPD BY		NTS	
DIBEKU CMS		INDOIN ELECTRONICS	
		INDOIN	
CAD FILE NO		PLANT:-	
DWG NO: CPW114533		INDOIN ELECTRONICS	
		INDOIN	
		INDOIN ELECTRONICS	
		INDOIN	

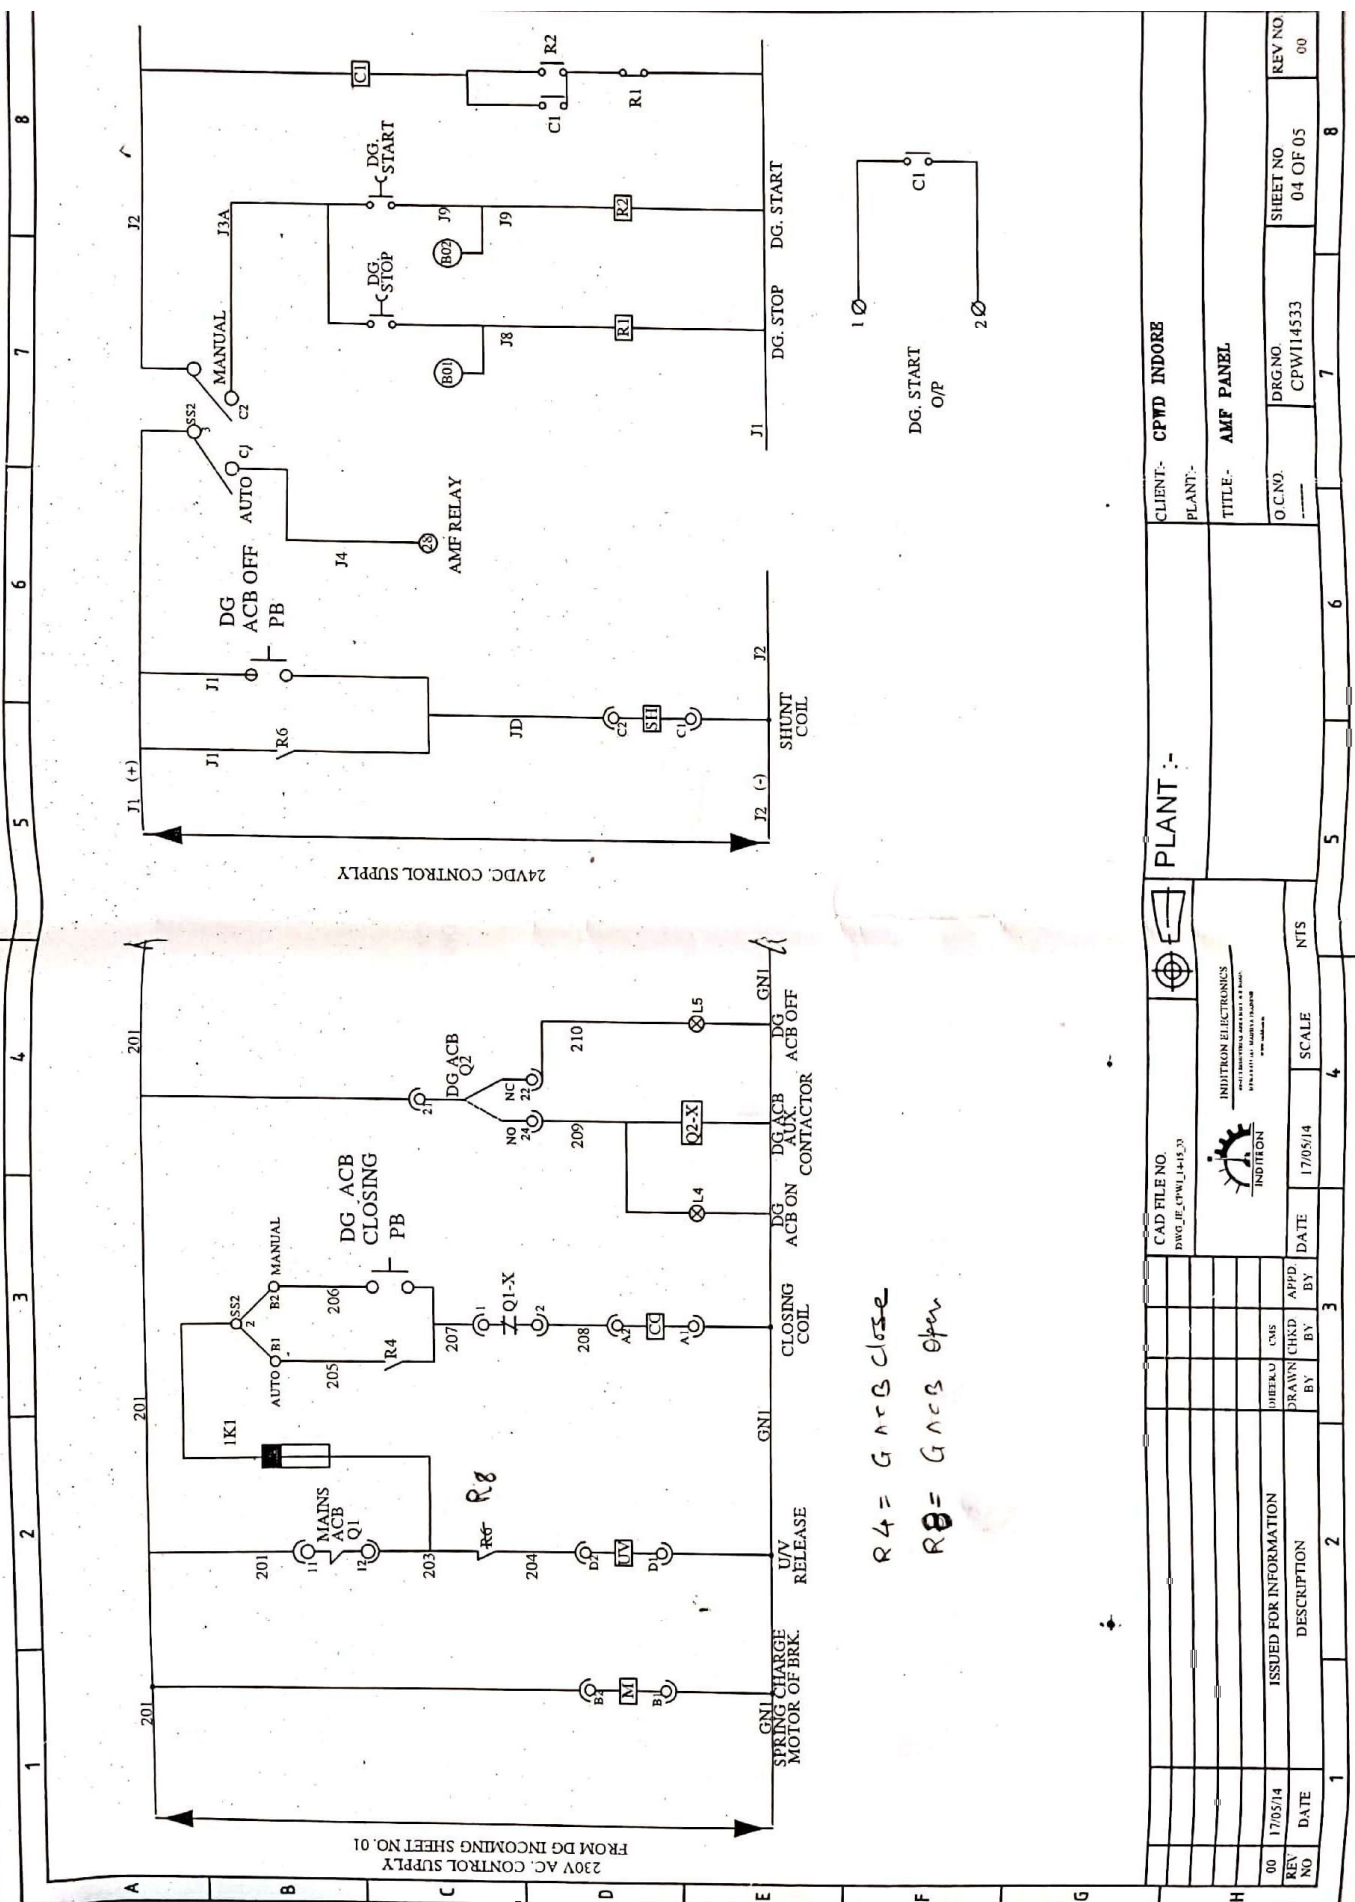

R4 = G A C B Close
 R8 = G A C B Open

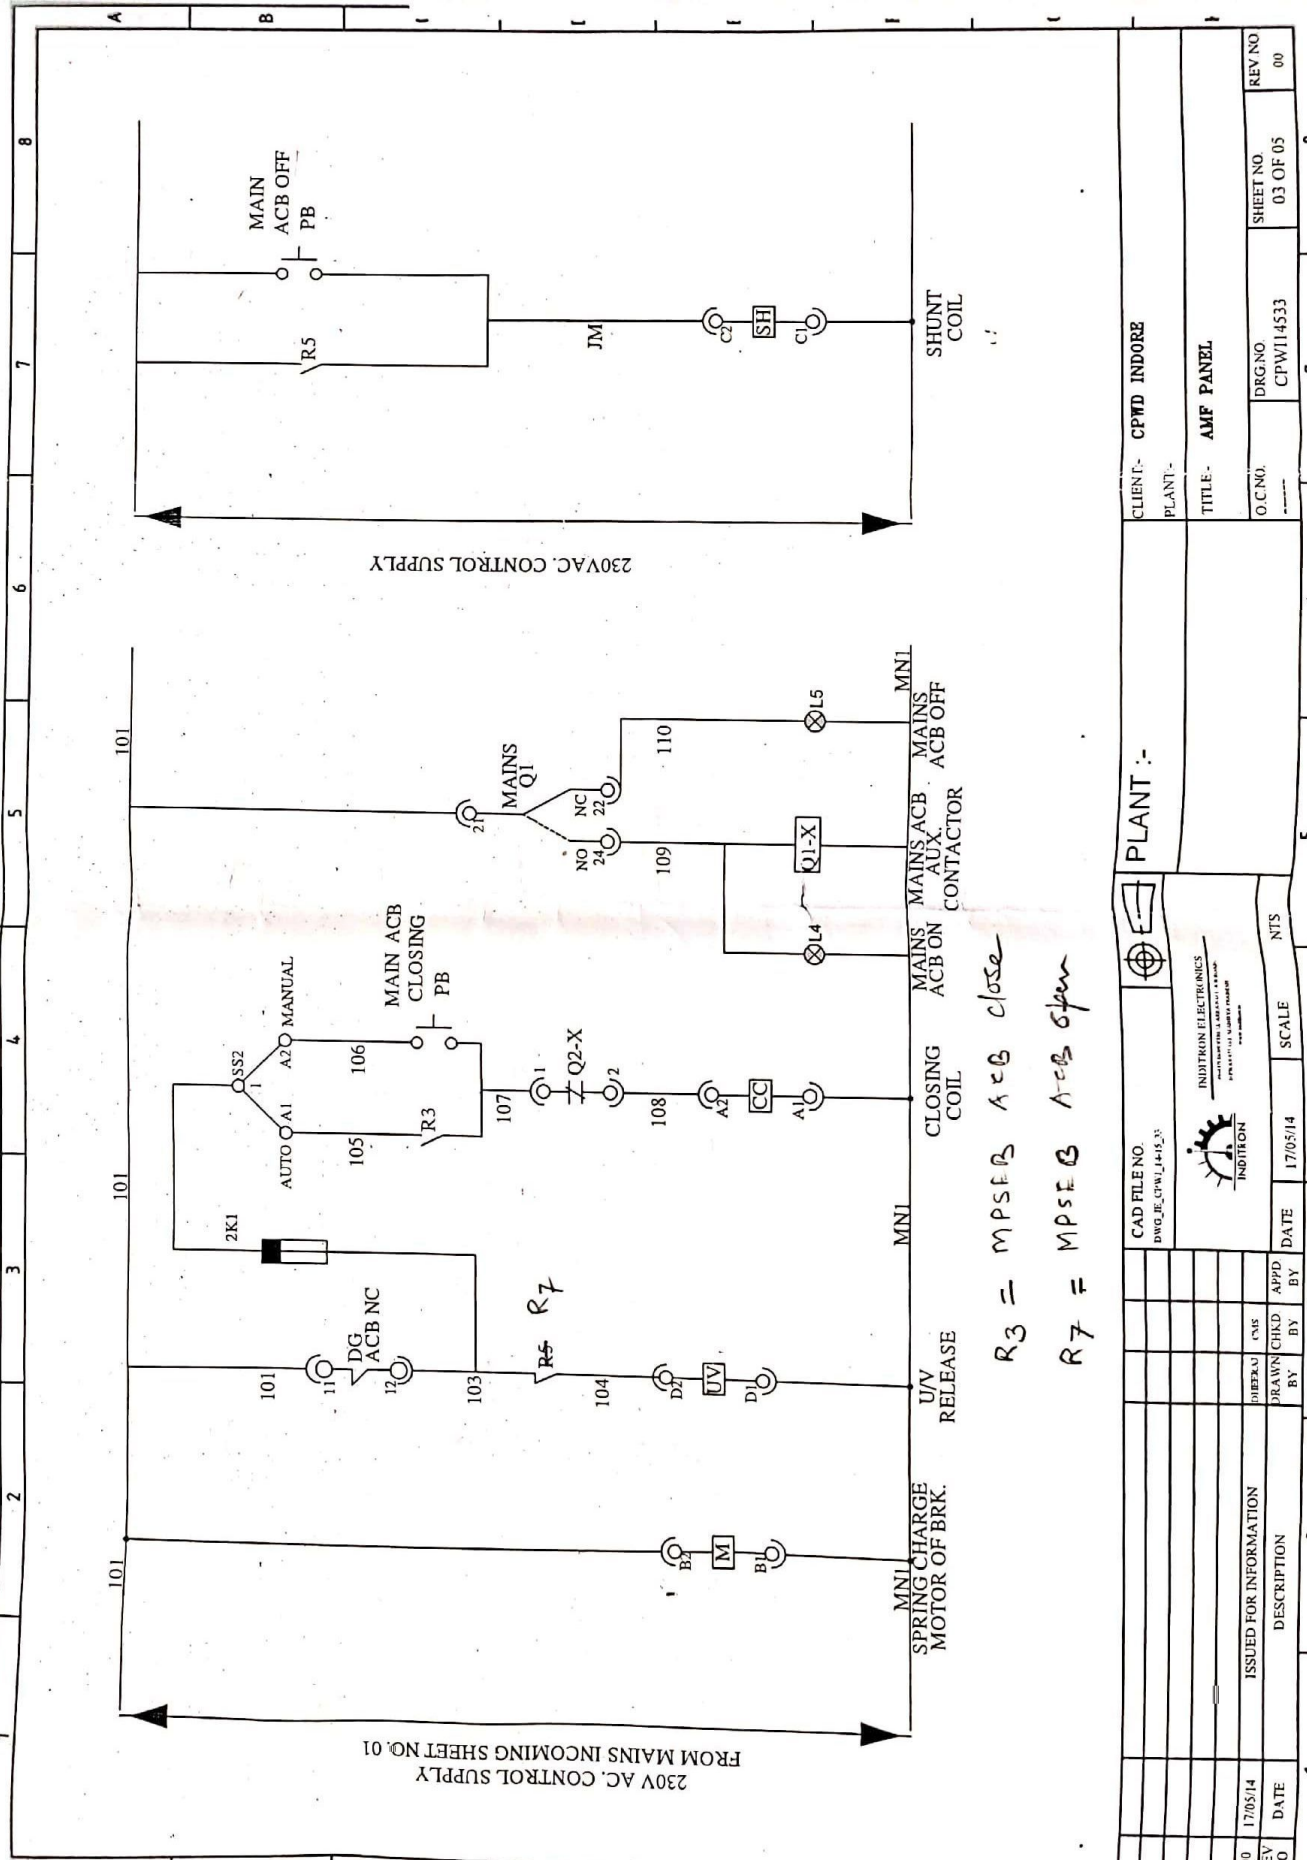


FROM MAINS INCOMING SHEET NO. 01
230V AC. CONTROL SUPPLY

230V AC. CONTROL SUPPLY


R3 = MPSEB ACB Close
R7 = MPSEB ACB Open

1		2		3		4		5		6		7		8	
A		B		C		D		E		F		G		H	
REV NO		17/05/14		DATE		ISSUED FOR INFORMATION		DRAWN BY		CHKD BY		APPD BY		SHEET NO.	
00		17/05/14												03 OF 05	
O.C. NO.		17/05/14		DATE		SCALE		NTS		DRG. NO.		CPWI14533		REV NO.	
		17/05/14		17/05/14										00	
CLIENT-		CPWD INDORE		PLANT-		INDITRON ELECTRONICS		INDITRON		INDITRON ELECTRONICS		INDITRON		INDITRON	
TITLE-		AMP PANEL		PLANT :-		INDITRON ELECTRONICS		INDITRON		INDITRON ELECTRONICS		INDITRON		INDITRON	

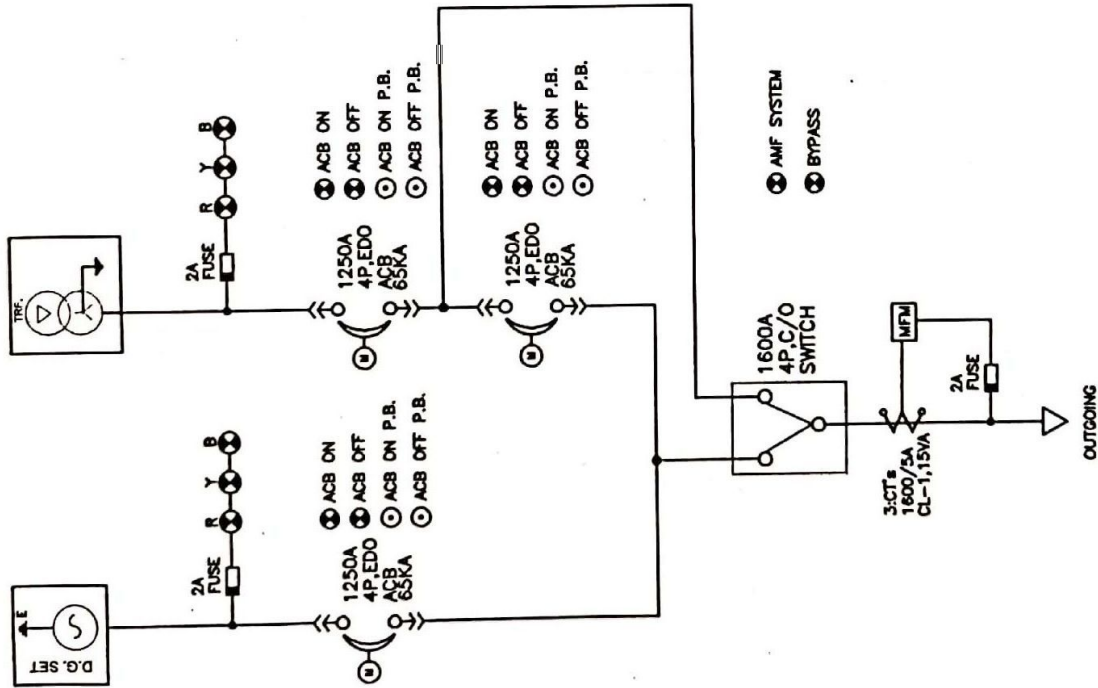

CHANGEOVER PANEL


2					
1	30.03.12	AS BUILT DRAWING	RISHA CONTROL ENGINEERS PVT.LTD. 297, Udyog Nagar Swarn Park, Mundka, N.D-41	M/S. KIRSUN ENGINEERS PVT. LTD.	DRG No.
0	07.12.12	FOR APPROVAL		A/C EX. ENGG., CPWD	12121096-01
REV. DATE	REMARKS	AN ISO : 9001 COMPANY	PROJECT	UGC-DAE, CSR INDORE	1
SCALE : N. T. S.	DRAWN: S.K.S.	CHECKED: R.K	APPR. BY: A.K.K	DRG. TITLE	SHEET 2 OF 2
			SLD OF CHANGEOVER PANEL		

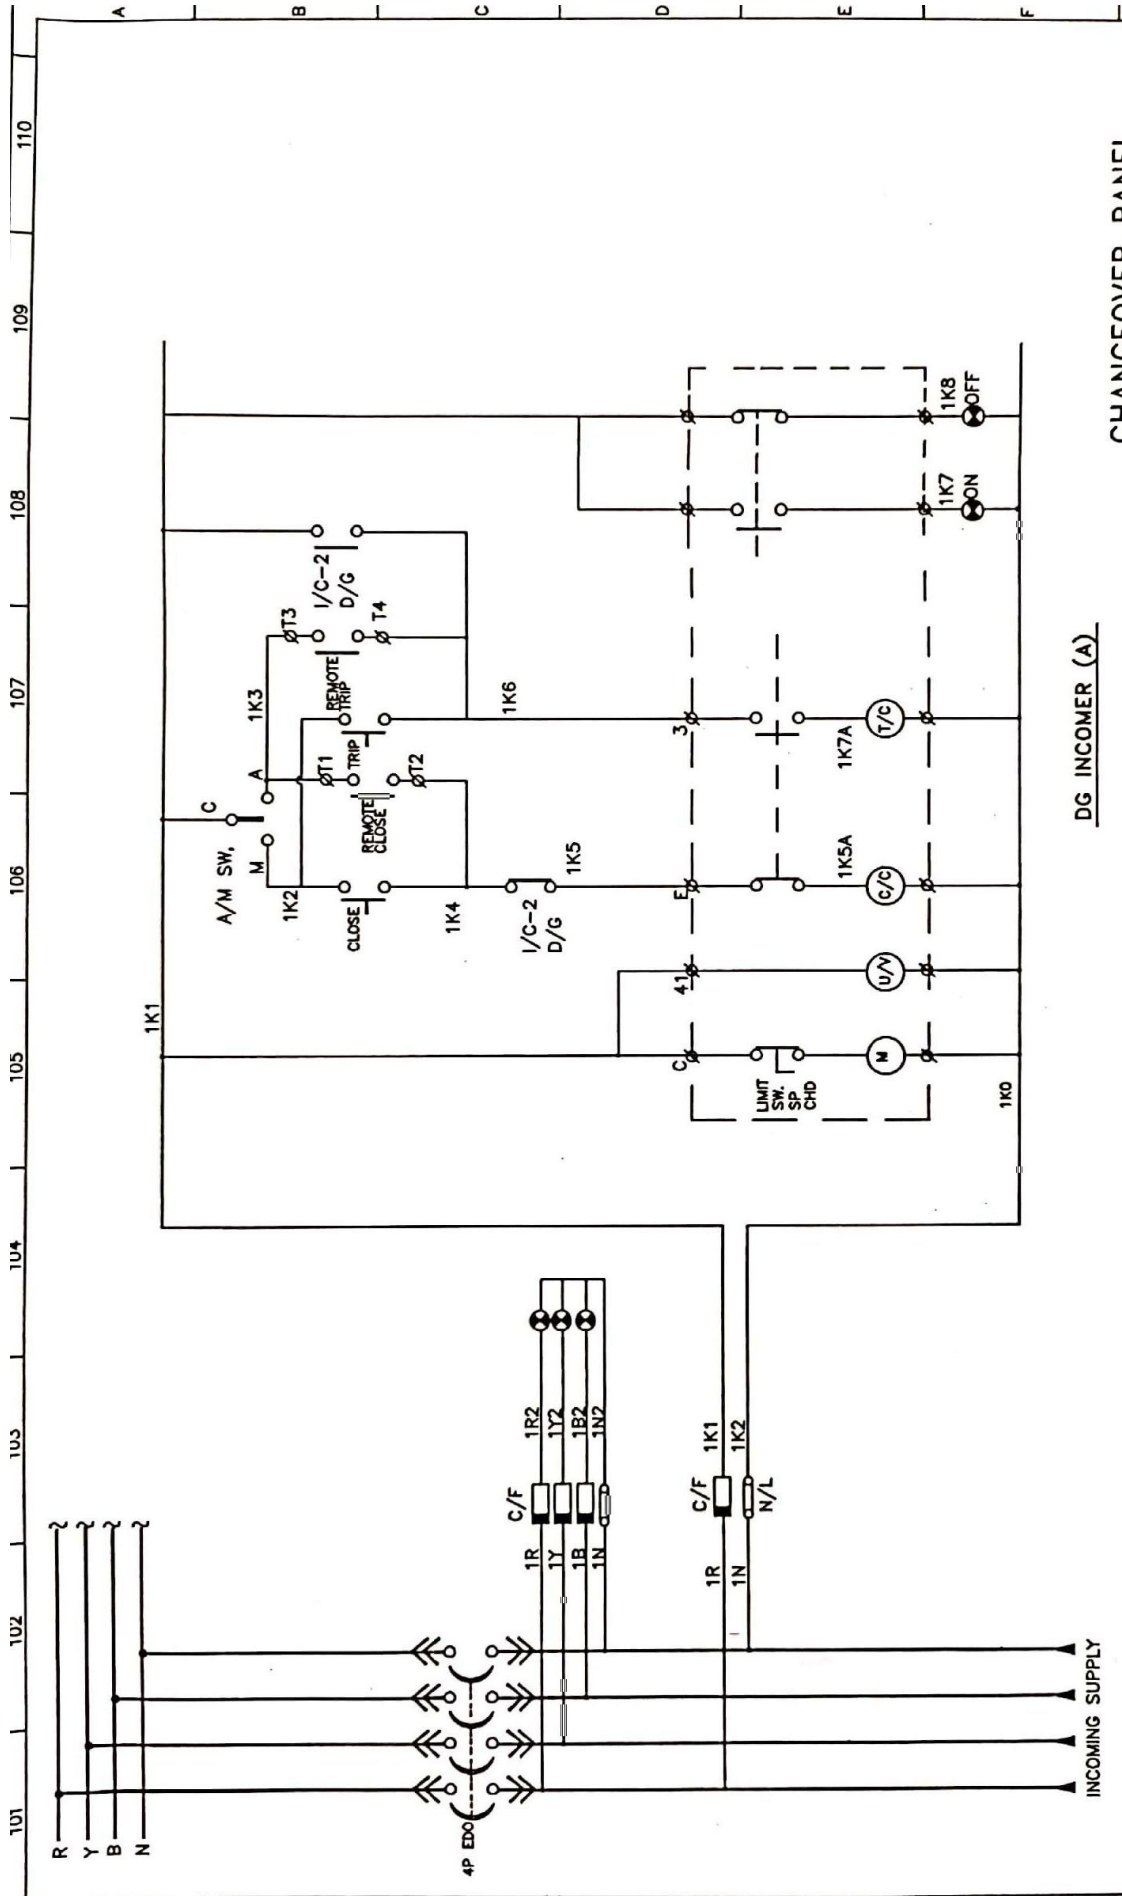

DG INCOMER (A)

CHANGEOVER PANEL


2	30.03.12	AS BUILT DRAWING	CLIENT	KIRSON ENGINEERS PVT. LTD.	DRG No.	12121096-21
1	07.12.12	FOR APPROVAL	PROJECT	UGC-DAE, CSR INDORE	REV	1
0		REMARKS	DRG. TITLE	WR. DIAG. FOR MAIN LT PANEL	SHEET 1 OF 4	
SCALE : N. T. S.		DRAWN: S.K.S	CHECKED: R.K	APPR. BY:		
RISHA CONTROL ENGINEERS PVT.LTD 297, Udyog Nagar Swarn Park, Mundka, N.D-41 AN ISO : 9001 COMPANY						

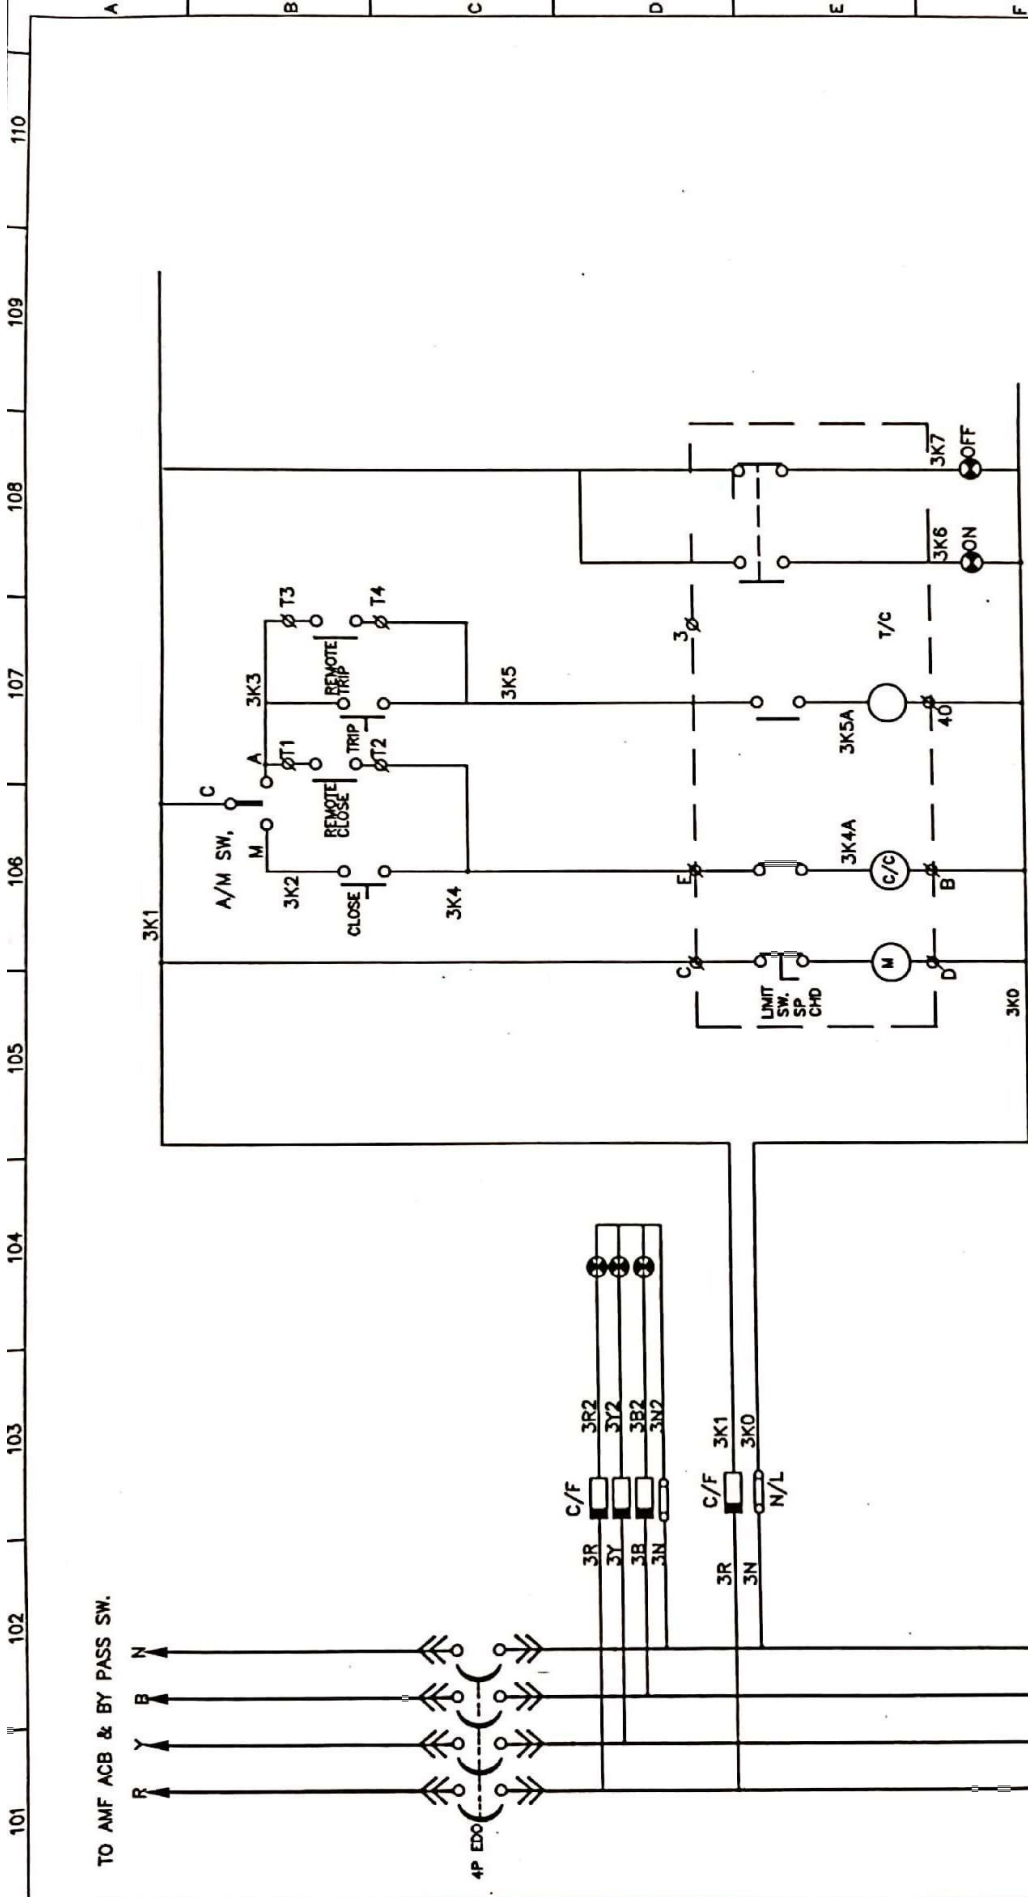

MAIN INCOMER (B)

CHANGEOVER PANEL

2	30.03.12	AS BUILT DRAWING	RISHA CONTROL ENGINEERS PVT.LTD 297, Udyog Nagar Swarn Park, Mundka, N.D-41 AN ISO : 9001 COMPANY	CLIENT	KIRSUN ENGINEERS PVT. LTD.	DRG No.	12121096-21 1
	0	07.12.12		FOR APPROVAL	PROJECT	UGC-DAE, CSR INDORE	REV
REV	DATE	REMARKS		DRG. TITLE	WIR. DIAG. FOR MAIN LT PANEL		SHEET 3 OF 4
	SCALE : N. T. S.		DRAWN: S.K.S	CHECKED: R.K	APPR. BY:		

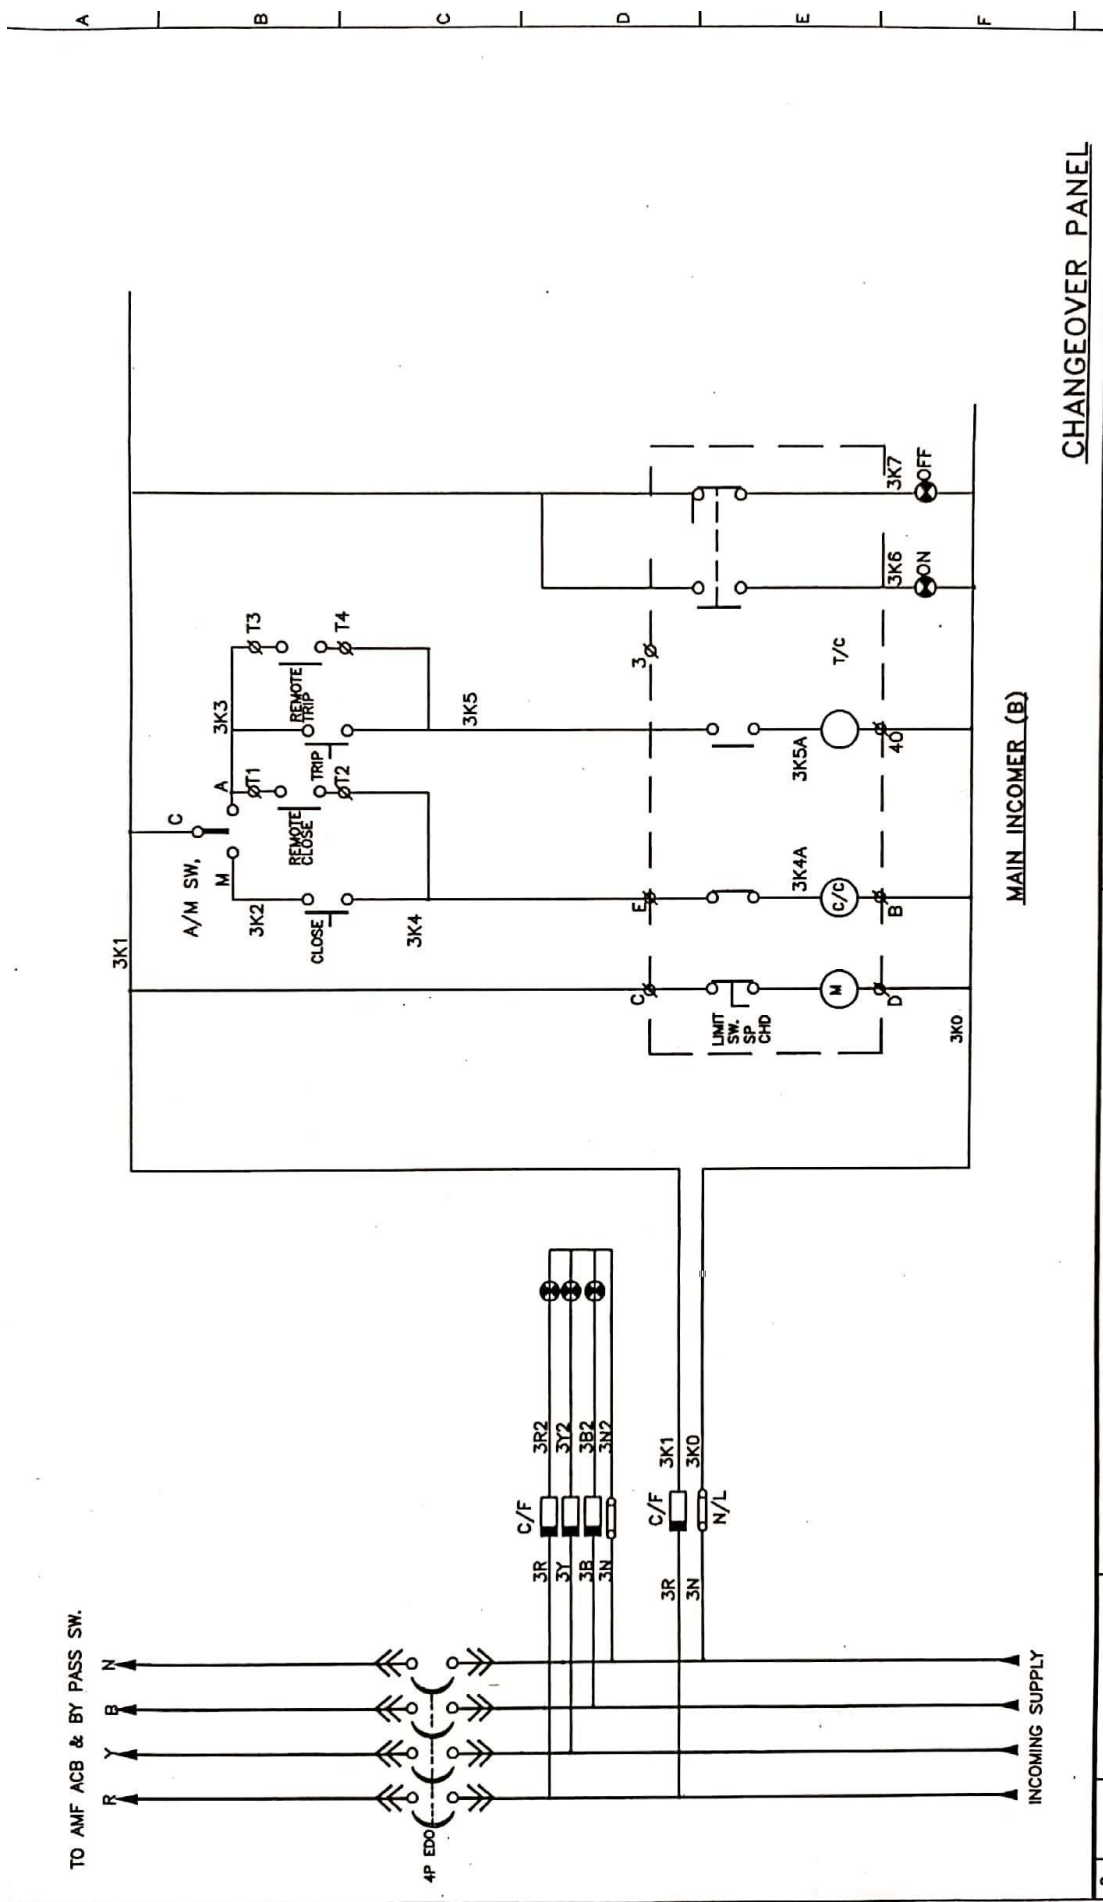

TO AMF ACB & BY PASS SW.

4P EDO

3R C/F 3R2
 3Y 3Y2
 3B 3B2
 3N 3N2

3R C/F 3K1
 3N 3K0
 N/L

MAIN INCOMER (B)

CHANGEOVER PANEL

A | B | C | D | E | F

101

102

103

104

105


106

107


108

109


110

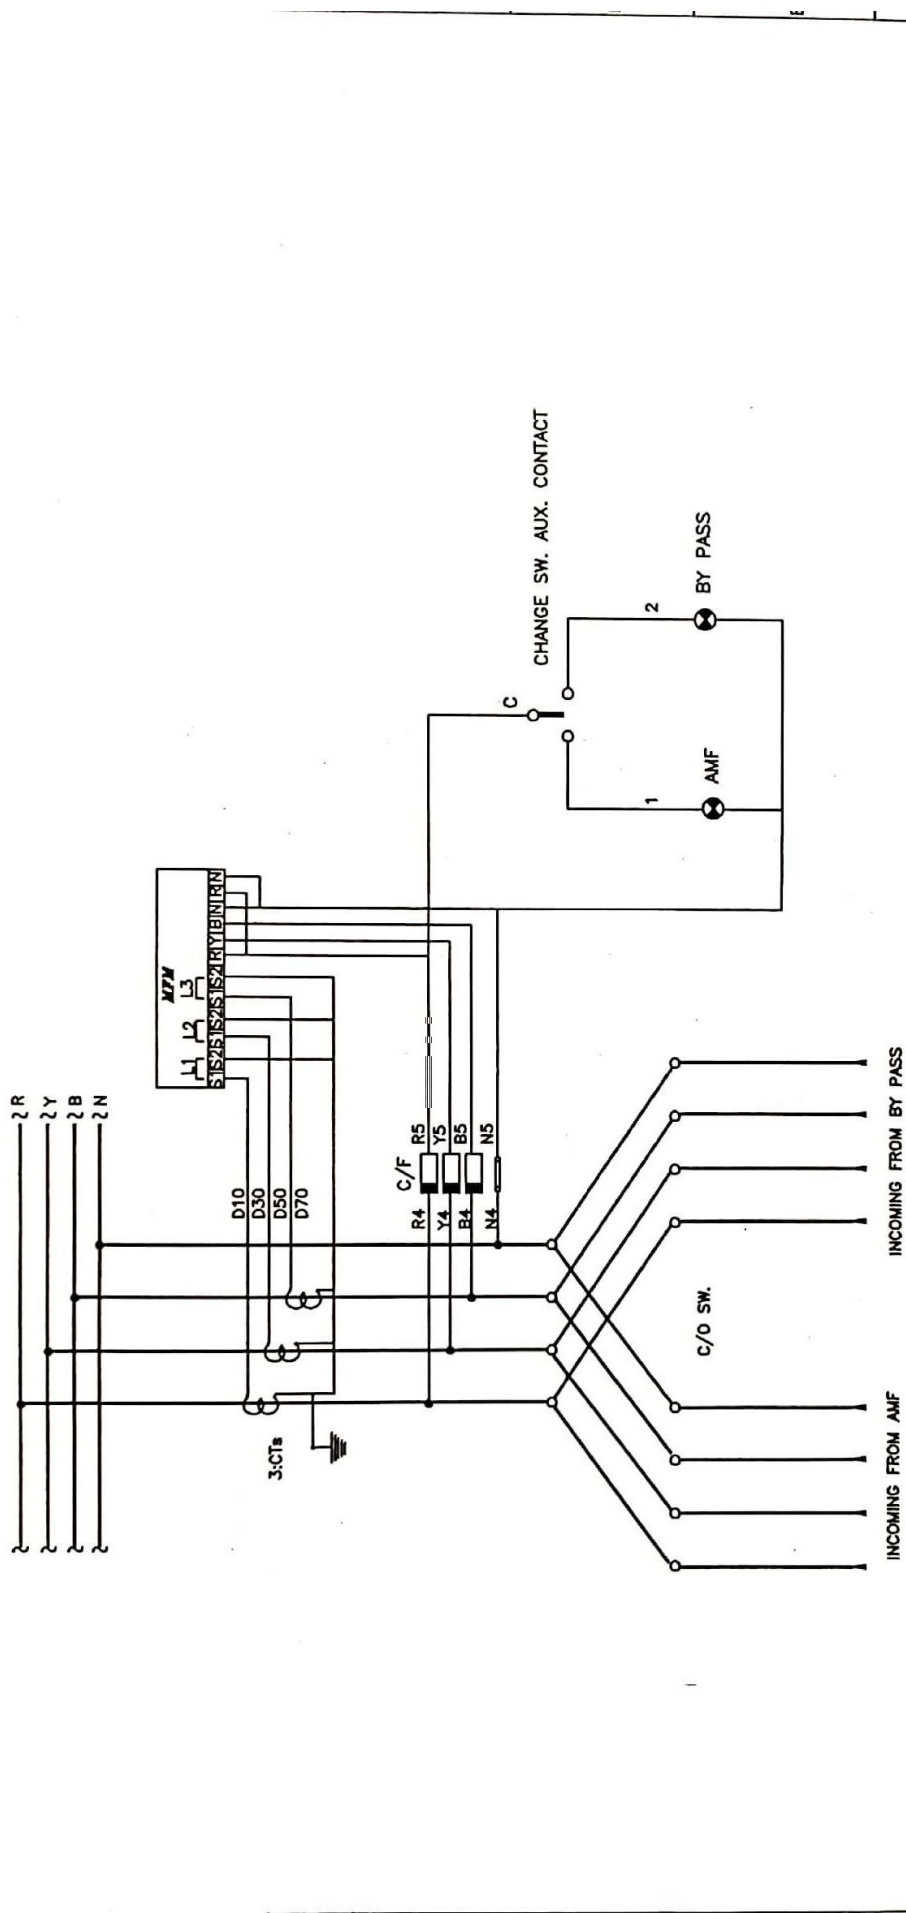

CHANGEOVER PANEL

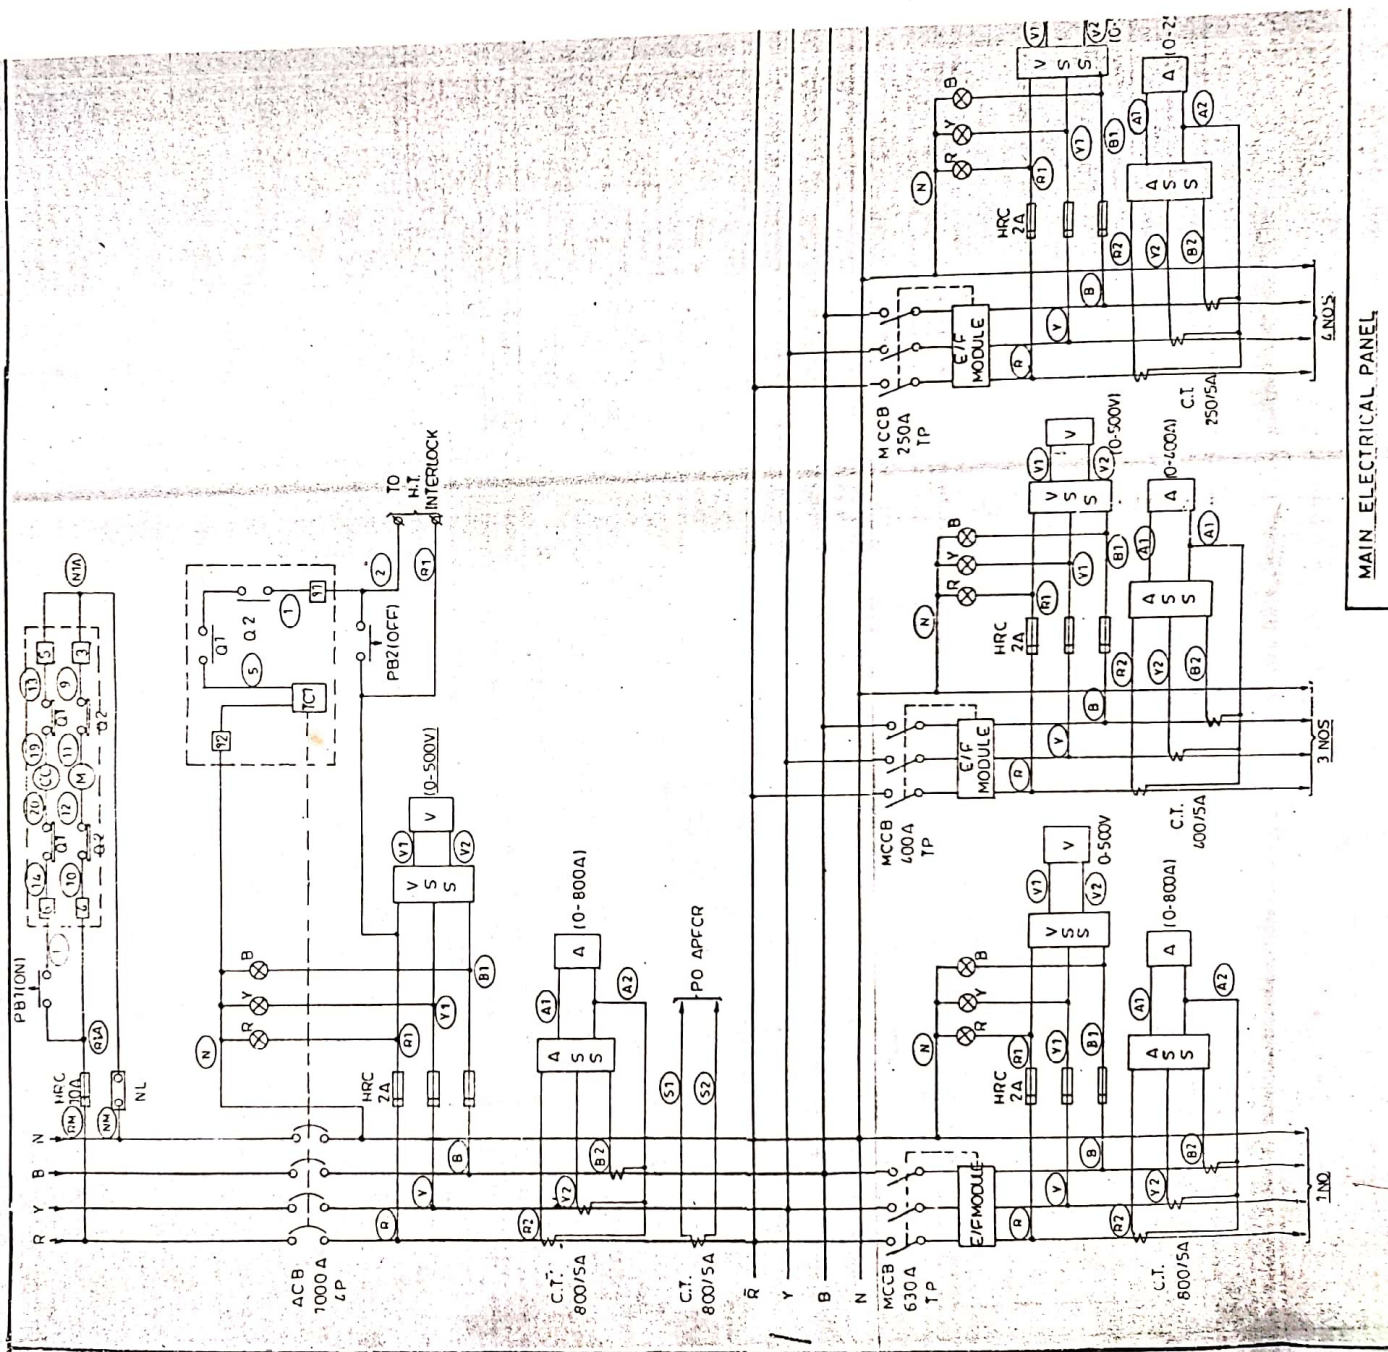


MAIN ELECTRICAL PANEL

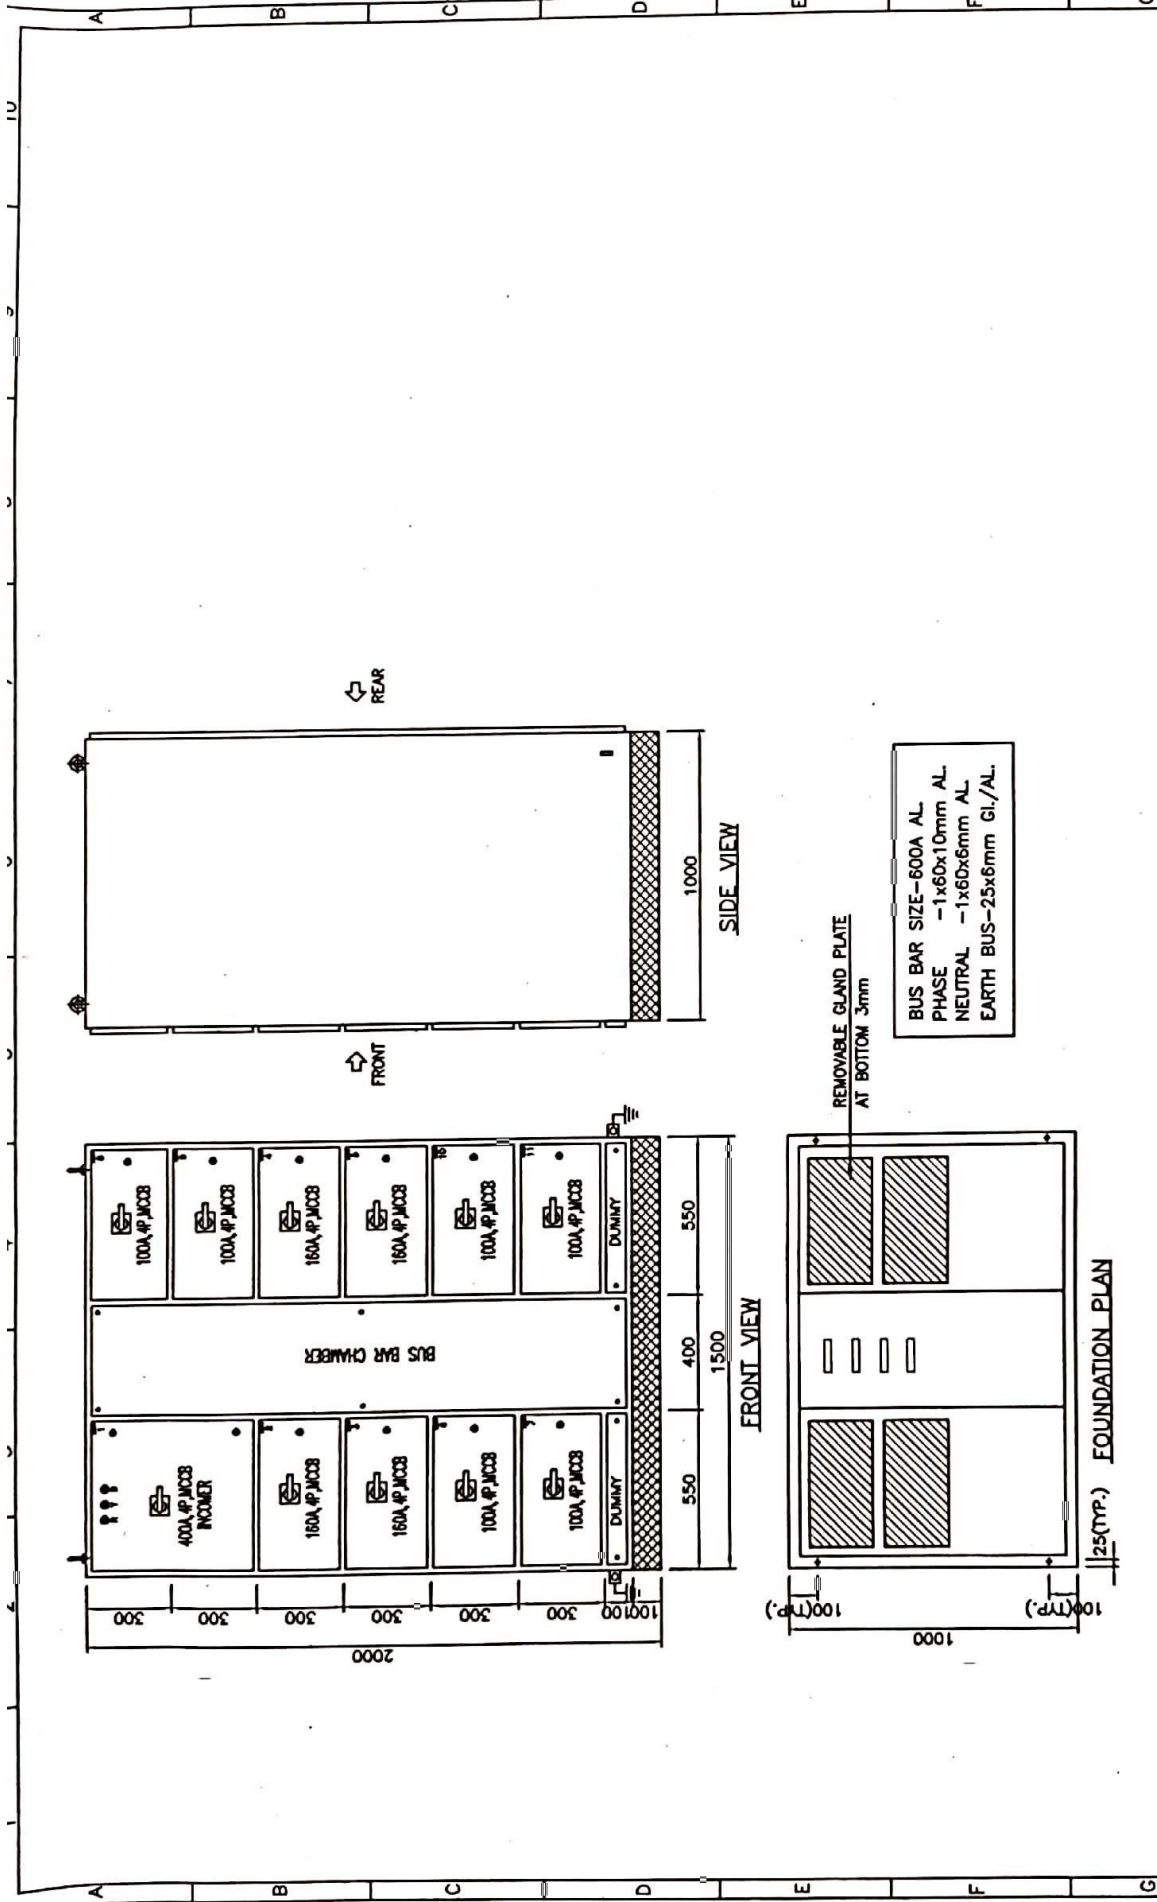

ALL DIMENSIONS ARE IN MM UNLESS NOTED OTHERWISE

NEW PANEL


2															
1	30.03.12	AS BUILT DRAWING													
0	07.12.12	FOR APPROVAL													
H	REV.	DATE	REMARKS												
SCALE : N. T. S.			DRAWN: S.K.S.	CHECKED: R.K	APPR. BY: A.K.K	DRG. TITLE	GA OF NEW PANEL				SHEET 1 OF 2				
RISHA CONTROL ENGINEERS PVT.LTD.			297, Udyog Nagar Swarn Park, Mundka, N.D--41			AN ISO : 9001 COMPANY	CLIENT	M/S. KIRSUN ENGINEERS PVT. LTD.	DRG No.	12121096-02 1					
							A/C EX. ENGG., CPWD								
							UGC-DAE, CSR INDORE								

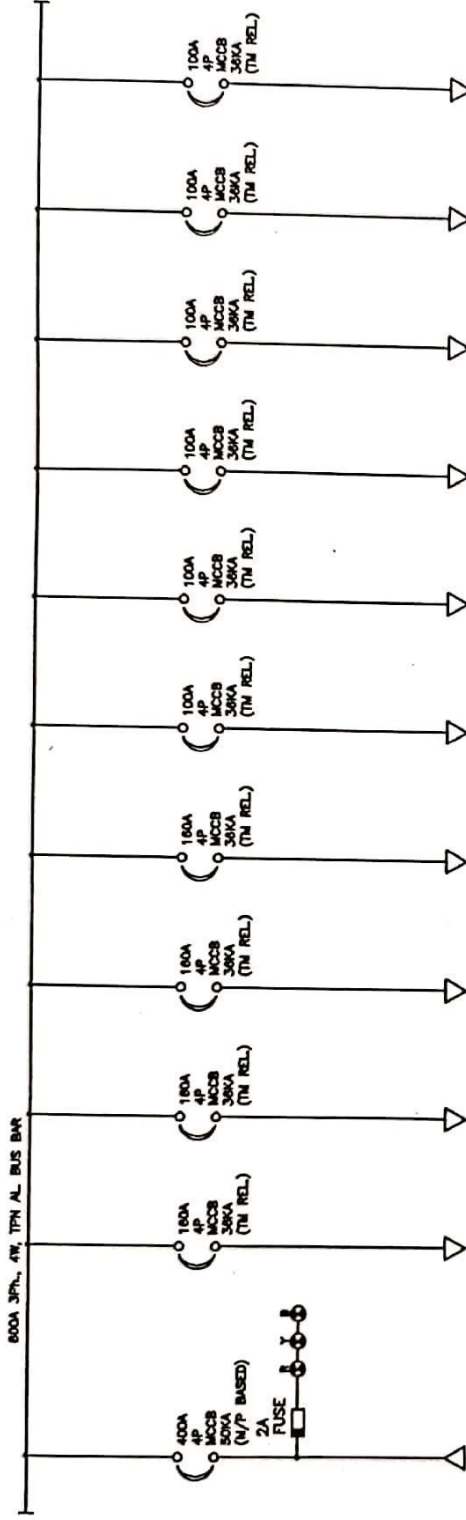

FEEDER NO.	FEEDER RATING/TYP	1	2	3	4	5	6	7	8	9	10	11
		400A	180A	180A	180A	180A	100A	100A	100A	100A	100A	100A
DESCRIPTION		INCOMER										
CABLE SIZE		—										
SCHEME TYPE												


NEW PANEL

2													REV
1	30.03.12	AS BUILT DRAWING											DRG No.
0	07.12.12	FOR APPROVAL											12121096-02 1
REV. DATE		REMARKS	RISHA CONTROL ENGINEERS PVT.LTD.			CLIENT			M/S. KIRSUN ENGINEERS PVT. LTD.			PROJECT	
			297, Udyog Nagar Swarn Park, Mundka, N.D-41			A/C EX. ENGG., CPWD			UGC-DAE, CSR INDORE			DRG. TITLE	
			AN ISO : 9001 COMPANY			APPR. BY: A.K.K			SLD OF NEW PANEL			SHEET 2 OF 2	
			DRAWN: S.K.S.			CHECKED: R.K							

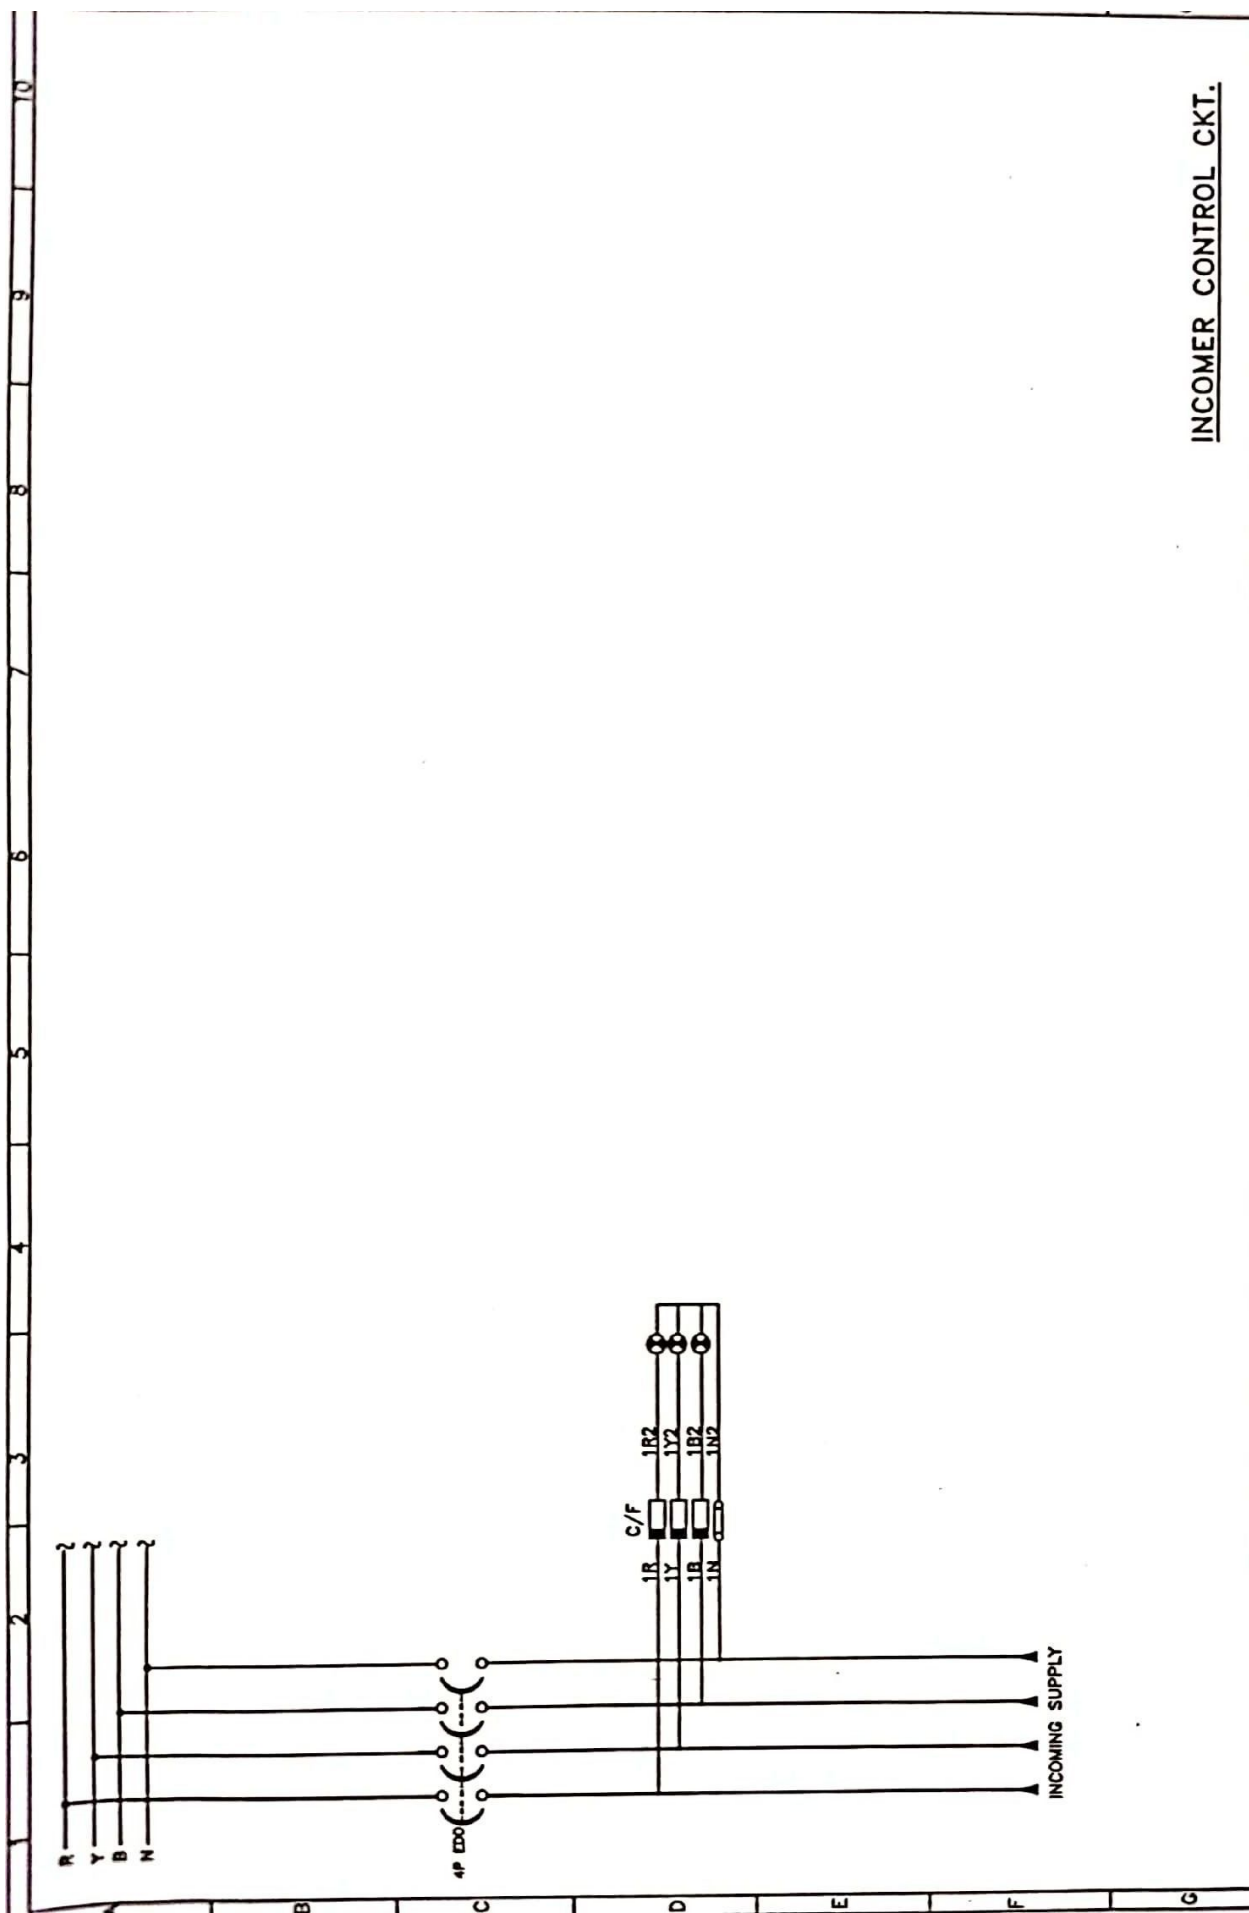

INCOMER CONTROL CKT.

2				M/S. KIRSUN ENGINEERS PVT. LTD.	DRG No.	12121096-22 1	REV
	RISHA CONTROL ENGINEERS PVT.LTD.			A/C EX. ENGG., CPWD			
	297, Udyog Nagar Swam Park, Mundka, N.D-41			UGC-DAE, CSR INDORE			
	AN ISO : 9001 COMPANY			WIR. DIAG. OF NEW PANEL			
	DRAWN: S.K.S.	CHECKED: R.K	APPR. BY: A.K.K	DRG. TITLE			SHEET 1 OF 1
	SCALE : N. T. S.						
1	30.03.12	AS BUILT DRAWING					
0	07.12.12	FOR APPROVAL					
REV.	DATE	REMARKS					

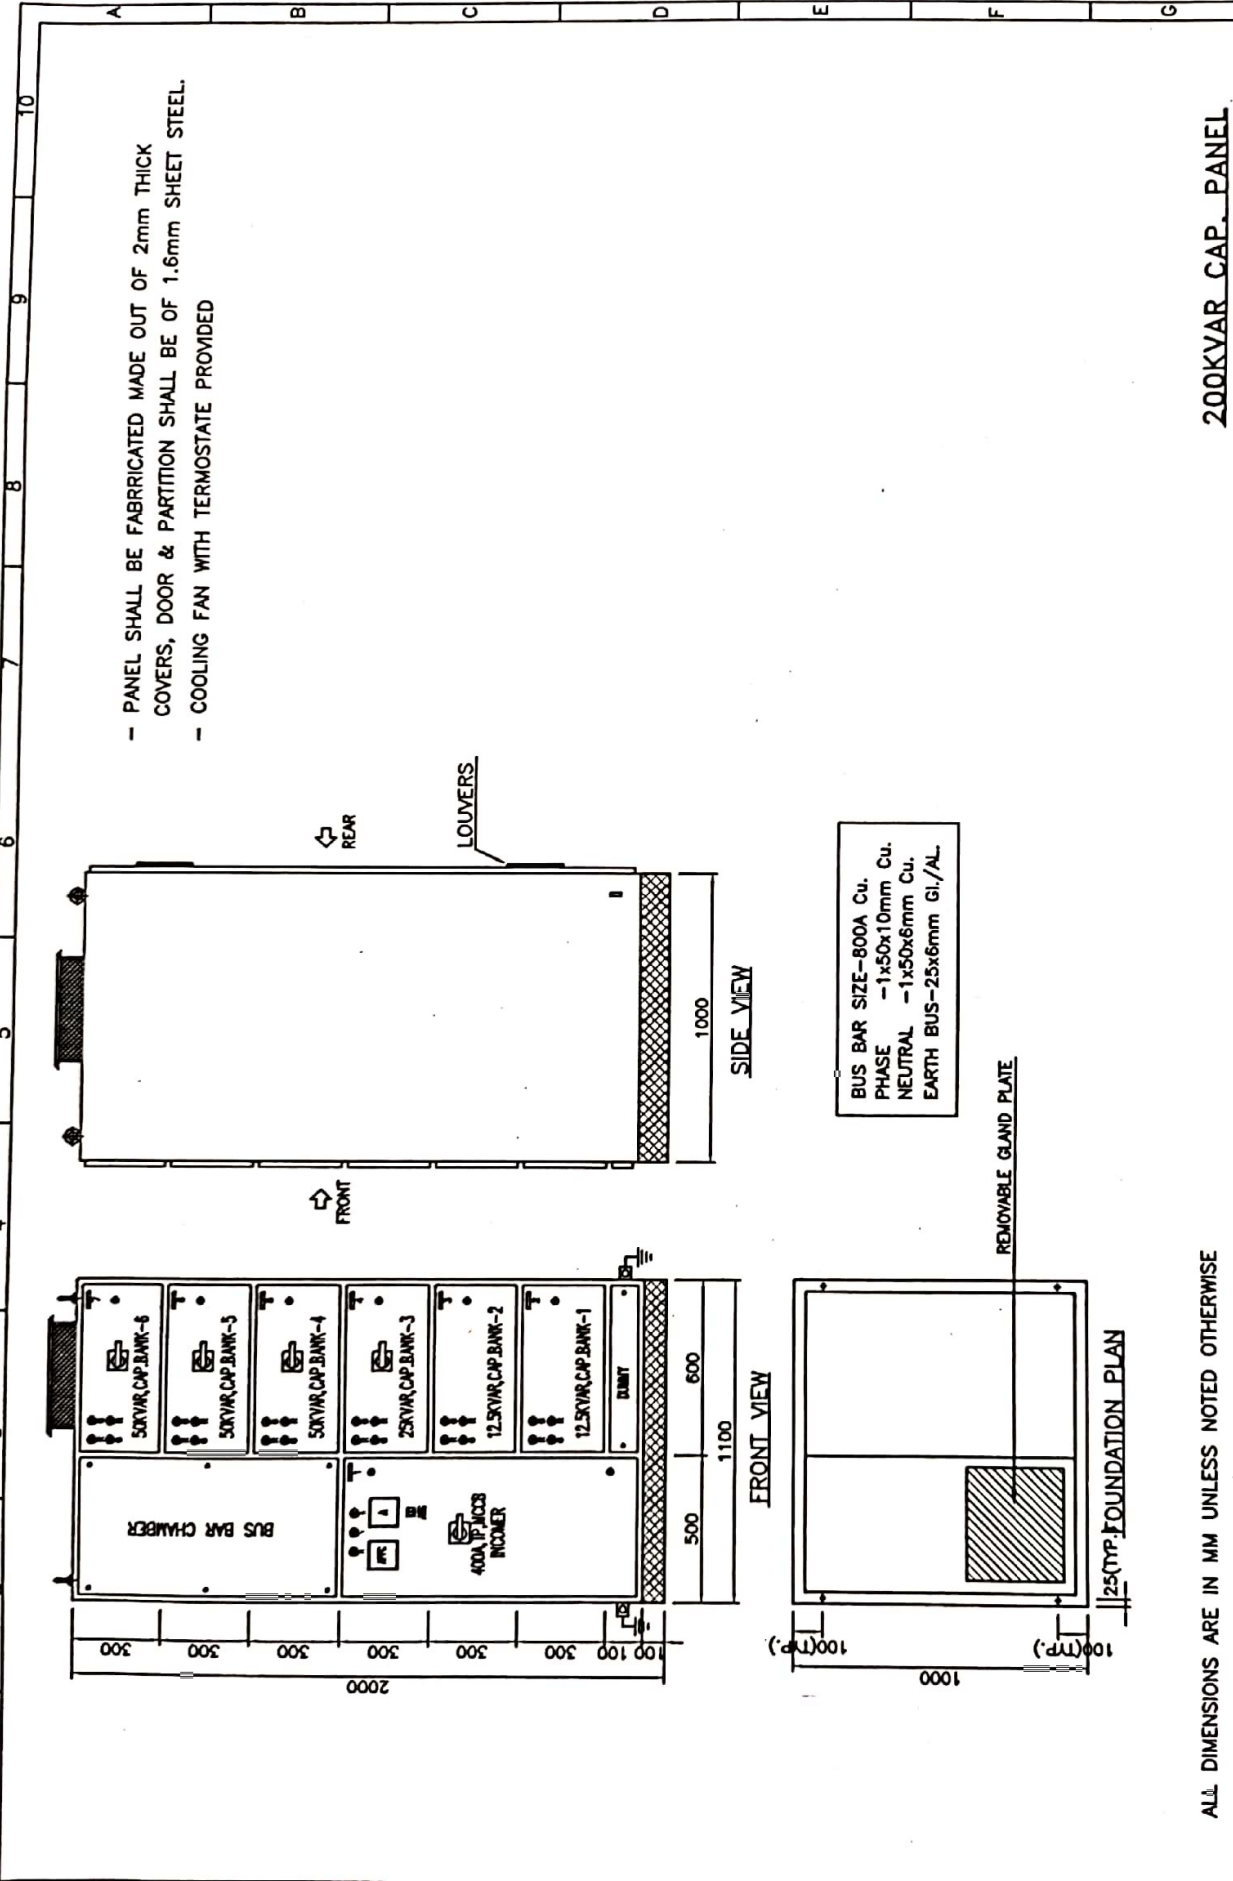

ALL DIMENSIONS ARE IN MM UNLESS NOTED OTHERWISE


200KVAR CAP. PANEL

2													
1	30.03.12	AS BUILT DRAWING											
0	07.12.12	FOR APPROVAL											
REV.	DATE	REMARKS											
SCALE : N. T. S.			DRAWN: S.K.S.			CHECKED: R.K			APPR. BY: A.K.K			DRG. TITLE	
						RISHA CONTROL ENGINEERS PVT.LTD.			CLIENT			M/S. KIRSUN ENGINEERS PVT. LTD.	
						297, Udyog Nagar Swarn Park, Mundka, N.D-41			A/C EX. ENGG., CPWD			DRG No.	
						AN ISO : 9001 COMPANY			PROJECT			12121096-03 1	
									UGC-DAE, CSR INDORE			REV	
									GA OF 200KVAR CAPACITOR PANEL			SHEET 1 OF 2	

BUS BAR SIZE-800A Cu.
 PHASE -1x50x10mm Cu.
 NEUTRAL -1x50x6mm Cu.
 EARTH BUS-25x6mm GI/AL


REMOVABLE GLAND PLATE

25(TYP) FOUNDATION PLATE

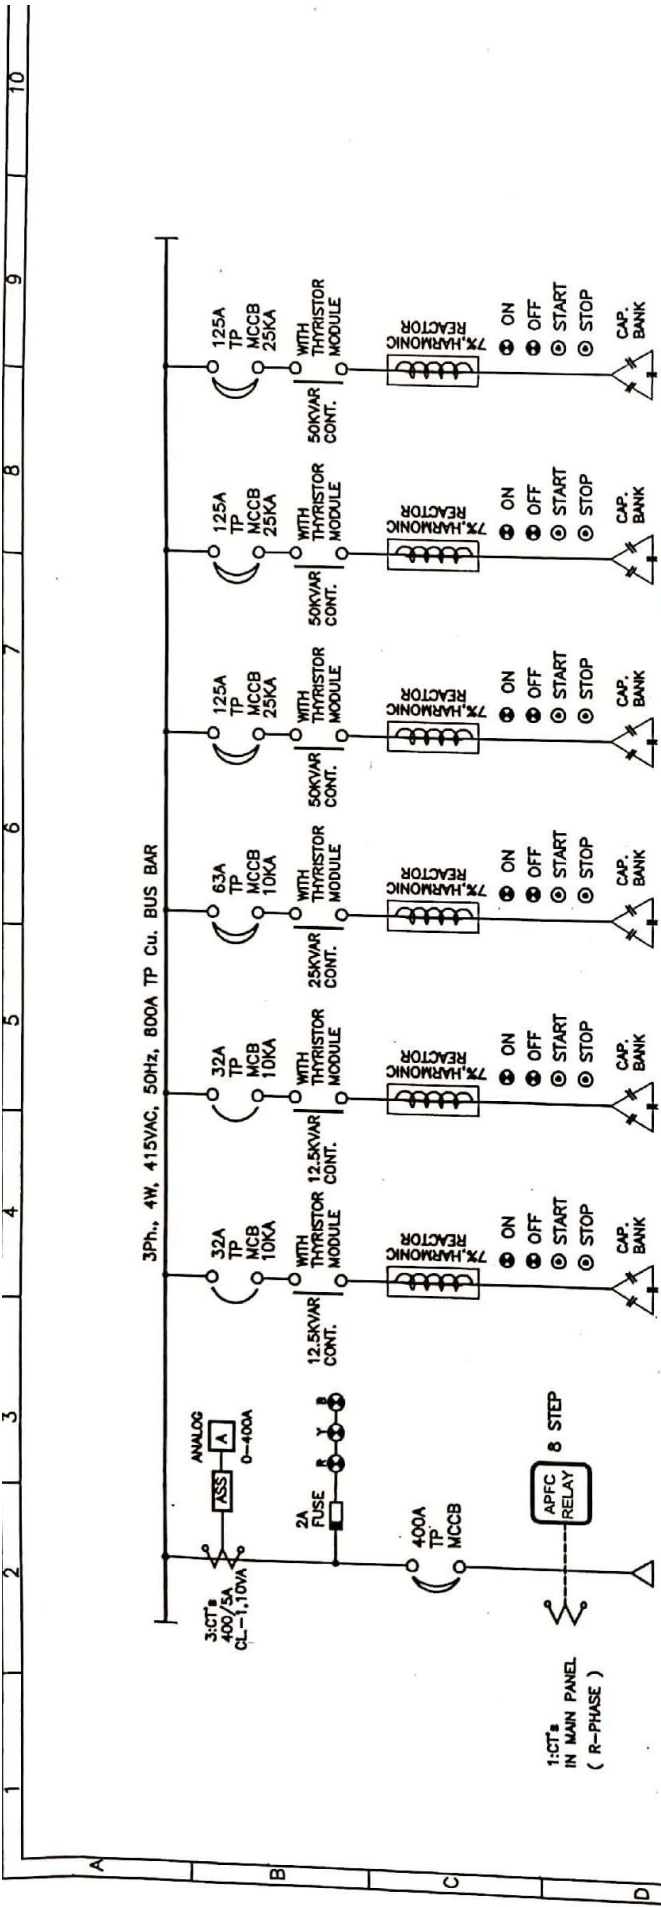


FEEDER NO.	FEEDER RATING	FEEDER DESCRIPTION	1	2	3	4	5	6	7
1	400A, TP, MCCB	INCOMER							
			12.5KVAR HEAVY DUTY MIXED DILELECTRICAL	12.5KVAR HEAVY DUTY MIXED DILELECTRICAL	25KVAR HEAVY DUTY MIXED DILELECTRICAL	50KVAR HEAVY DUTY MIXED DILELECTRICAL	50KVAR HEAVY DUTY MIXED DILELECTRICAL	50KVAR HEAVY DUTY MIXED DILELECTRICAL	50KVAR HEAVY DUTY MIXED DILELECTRICAL
			CAPACITOR BANK-1	CAPACITOR BANK-2	CAPACITOR BANK-3	CAPACITOR BANK-4	CAPACITOR BANK-5	CAPACITOR BANK-6	CAPACITOR BANK-7

200KVAR CAP. PANEL

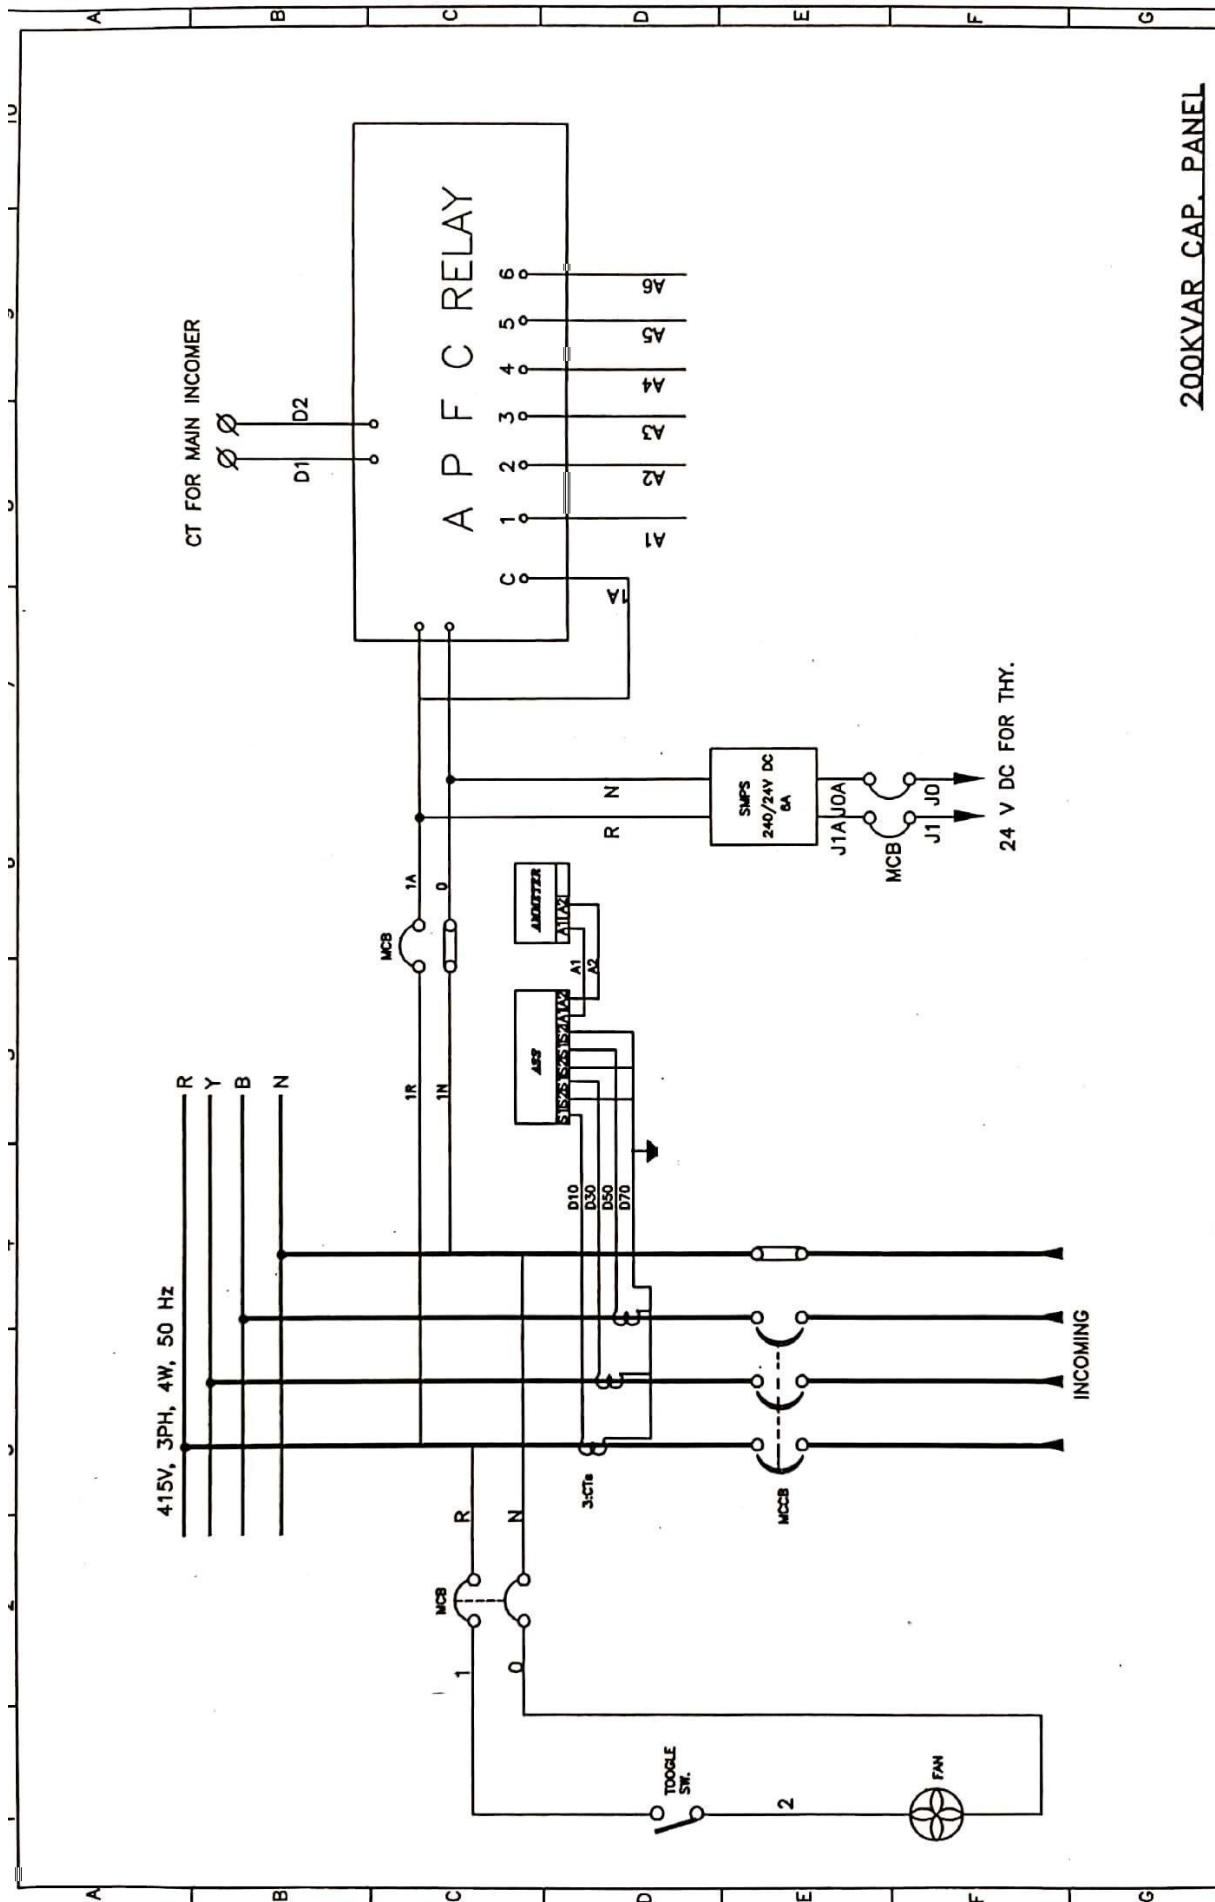


200KVAR CAP. PANEL

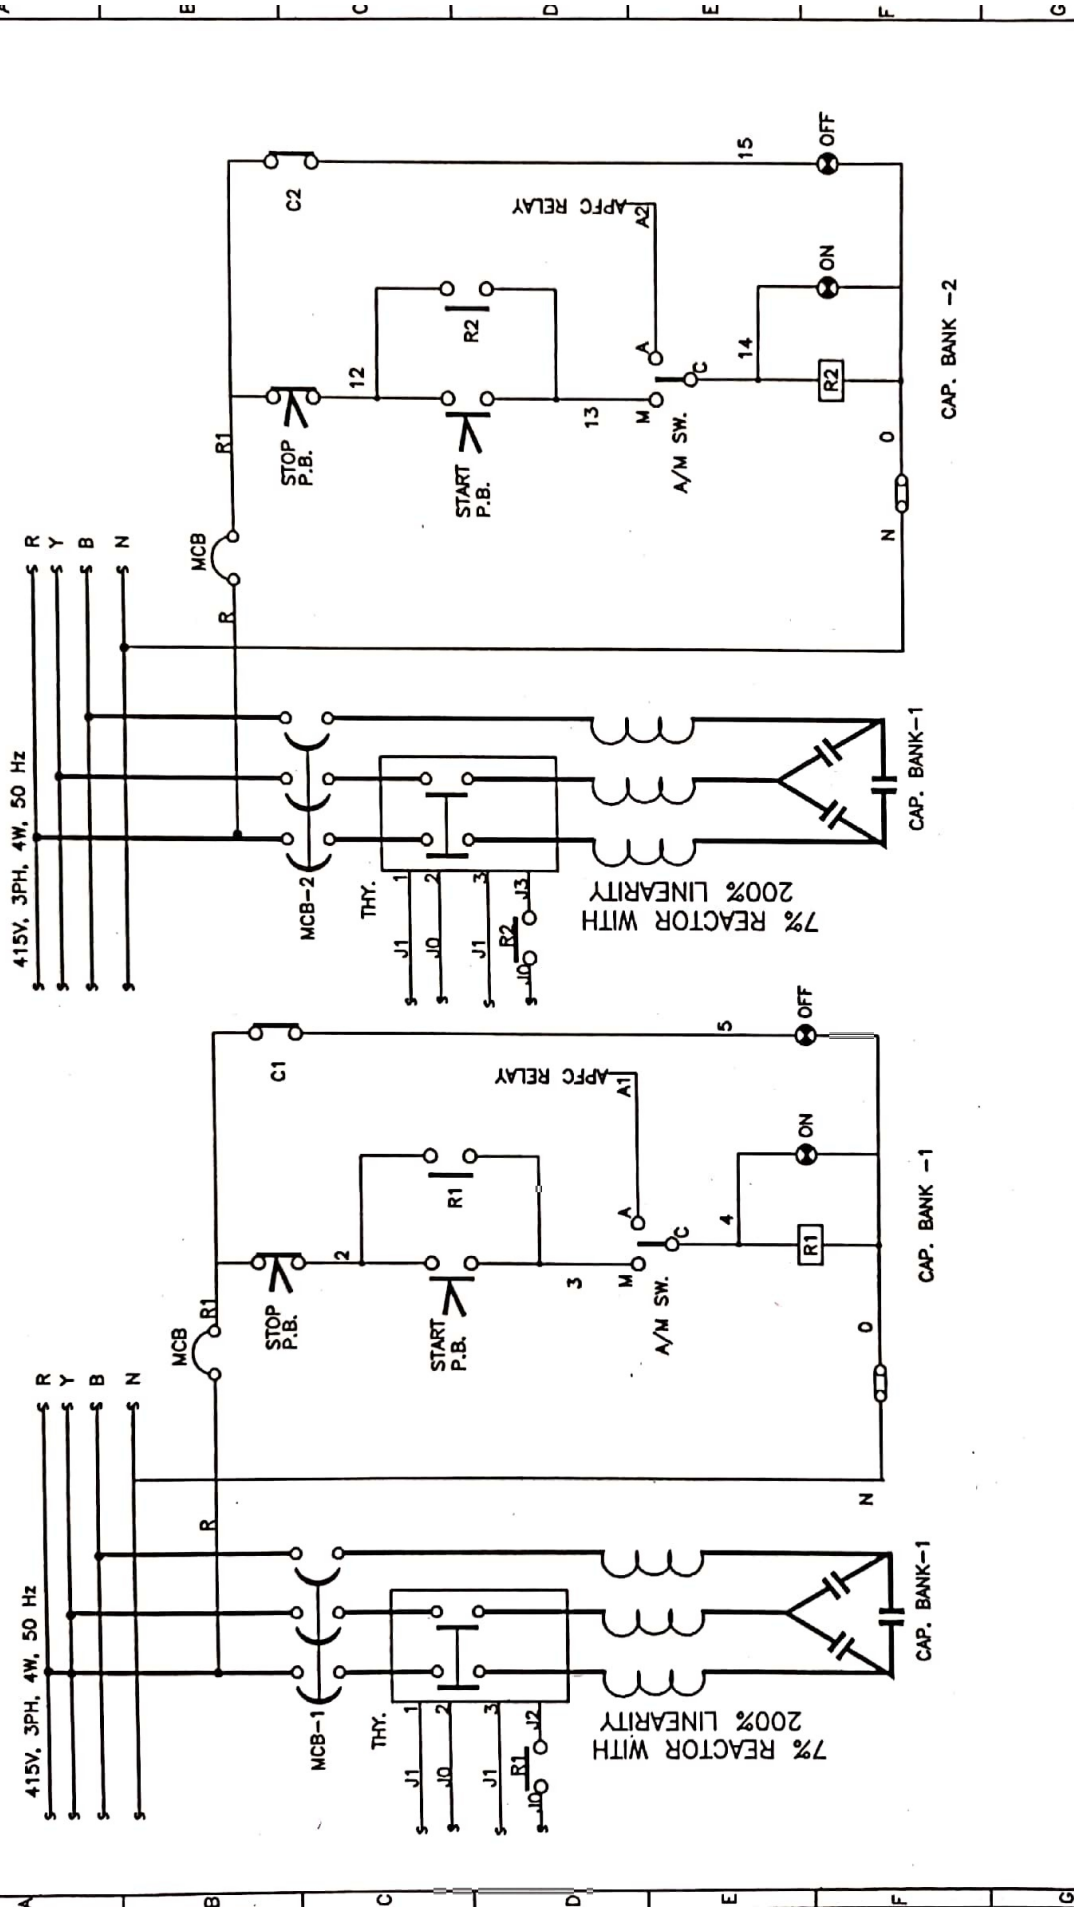


200KVAR CAP. PANEL

2	RISHA CONTROL ENGINEERS PVT.LTD.		CLIENT	M/S. KIRSUN ENGINEERS PVT. LTD.	DRG No.	12121096-23
	297, Udyog Nagar Swarn Park, Mundka, N.D-41		PROJECT	A/C EX. ENGG., CPWD	REV	1
1	30.03.12 AS BUILT DRAWING		DRG. TITLE	WIR. DIAG. OF 200KVAR CAPACITOR PANEL	SHEET 2 OF 4	
0	07.12.12 FOR APPROVAL		APPR. BY:	A.K.K	SHEET 2 OF 4	
REV. DATE	REMARKS		CHECKED:	R.K	SHEET 2 OF 4	
SCALE : N. T. S.		DRAWN:		S.K.S.	SHEET 2 OF 4	
AN ISO : 9001 COMPANY		APPR. BY:		A.K.K	SHEET 2 OF 4	

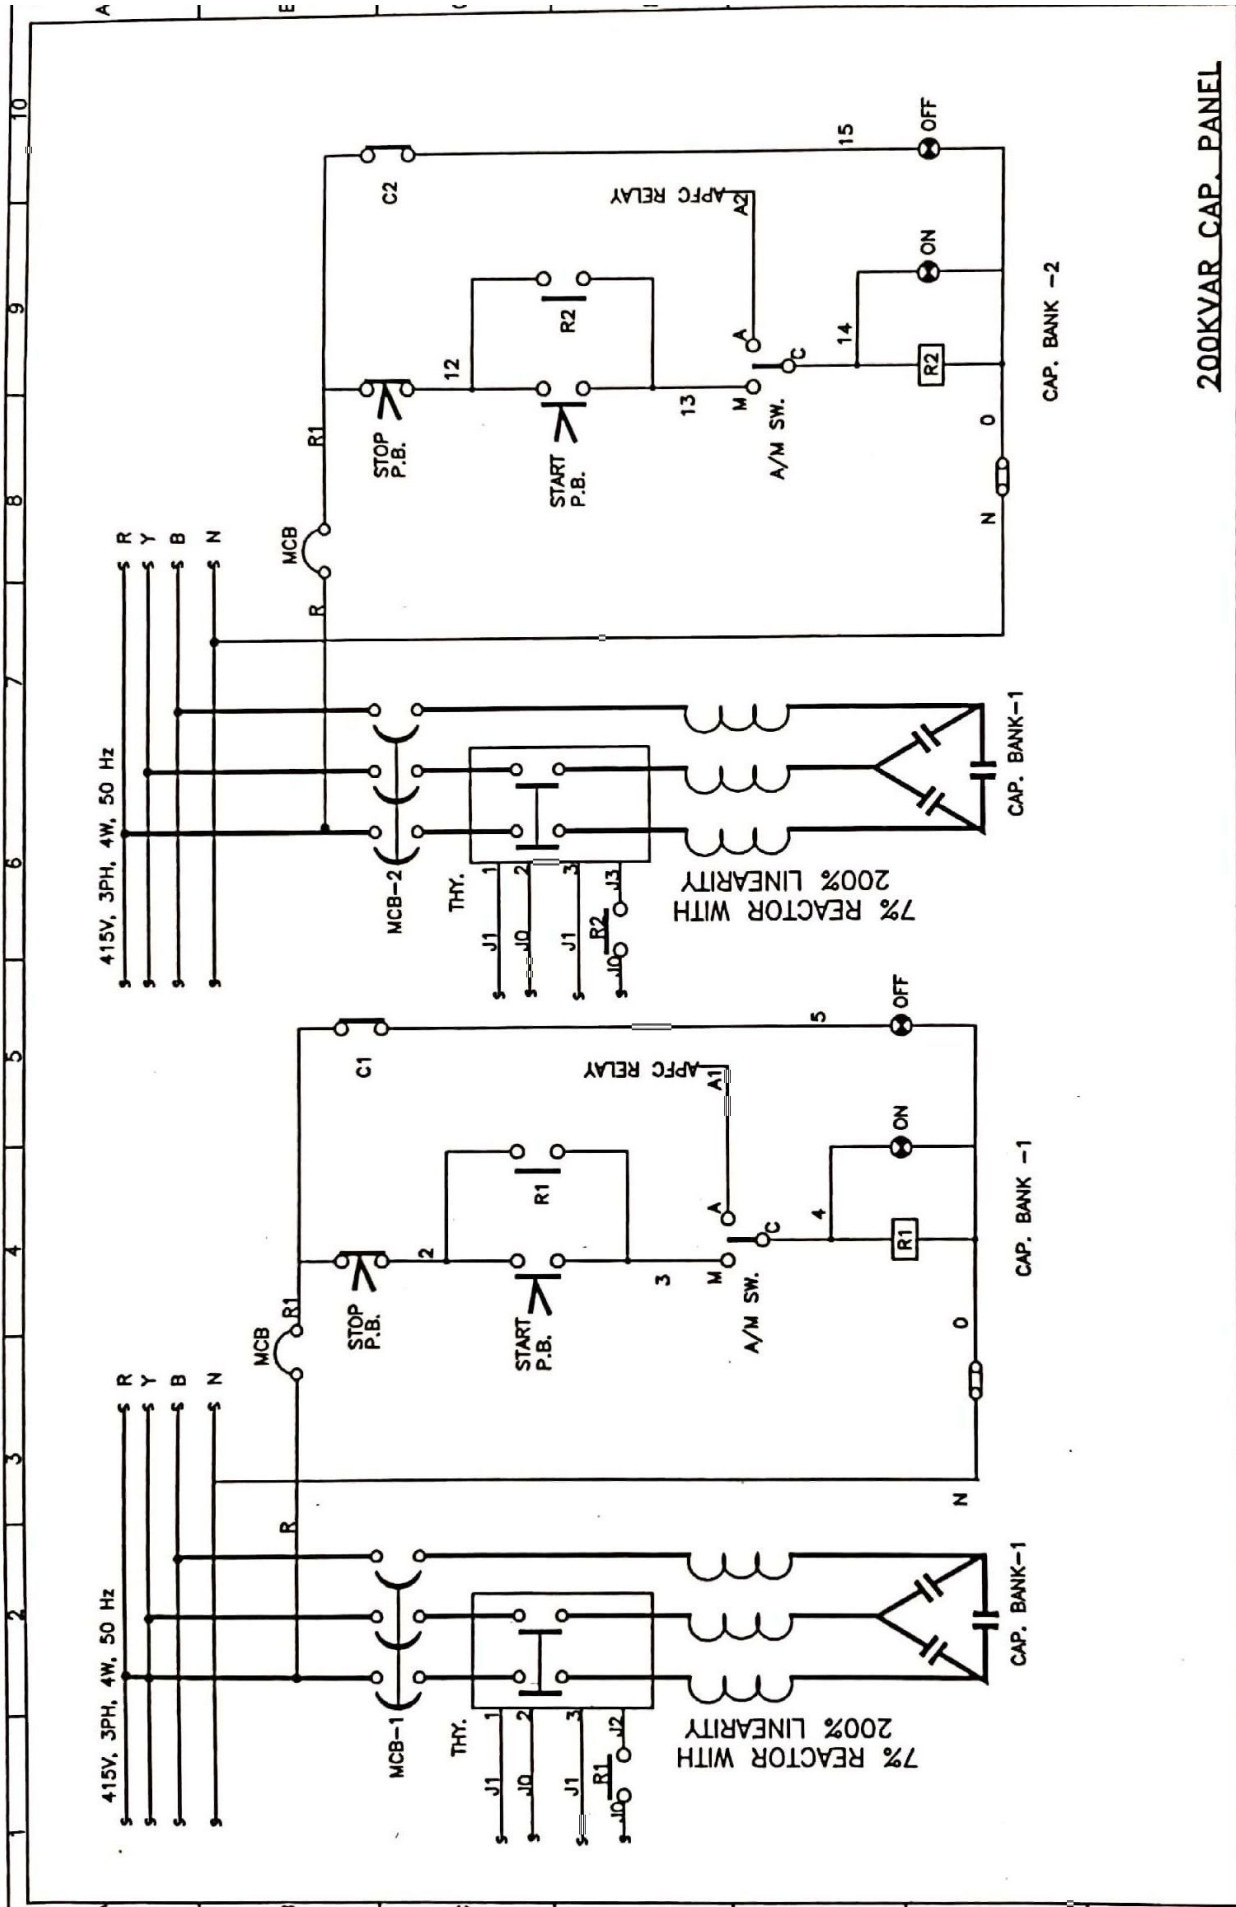


200KVAR CAP. PANEL

2									
1	30.03.12	AS BUILT DRAWING							
0	07.12.12	FOR APPROVAL							
REV.	DATE	REMARKS							
SCALE : N. T. S.			DRAWN: S.K.S.		CHECKED: R.K		APPR. BY: A.K.K		
RISHA CONTROL ENGINEERS PVT.LTD.			CLIENT		M/S. KIRSUN ENGINEERS PVT. LTD.		DRG No.		REV
297, Udyog Nagar Swarn Park, Mundka, N.D-41			PROJECT		A/C EX. ENGG., CPWD		12121096-23		1
AN ISO : 9001 COMPANY			DRG. TITLE		UGC-DAE, CSR INDORE		WIR. DIAG. OF 200KVAR CAPACITOR PANEL		SHEET 2 OF 4

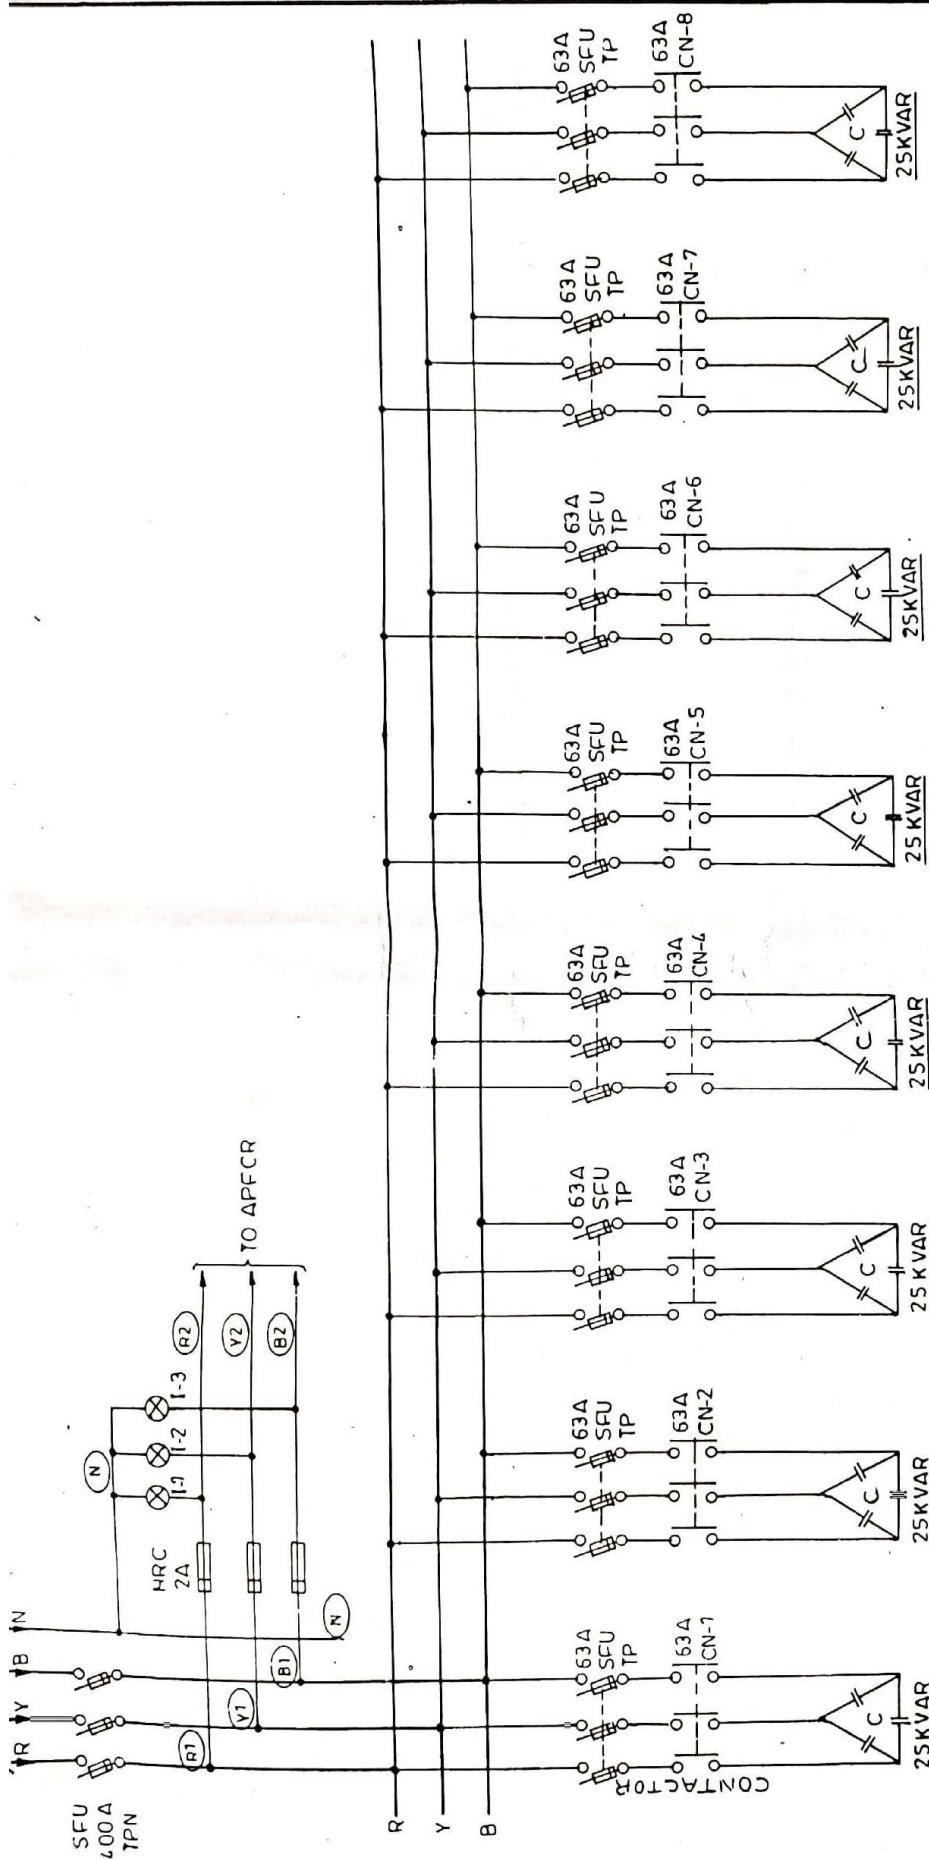

CAPACITOR PANEL	
POWER SCHEMATIC	DRG. NO.- VE/11/00/0
PROJECT I. U. C. D. A. V. V. INDORE.	
CONTRACTOR M/s VIJENDRA ELECTRICALS, INDORE.	
MFD. BY HERTZ ELECTRONICS, INDORE.	

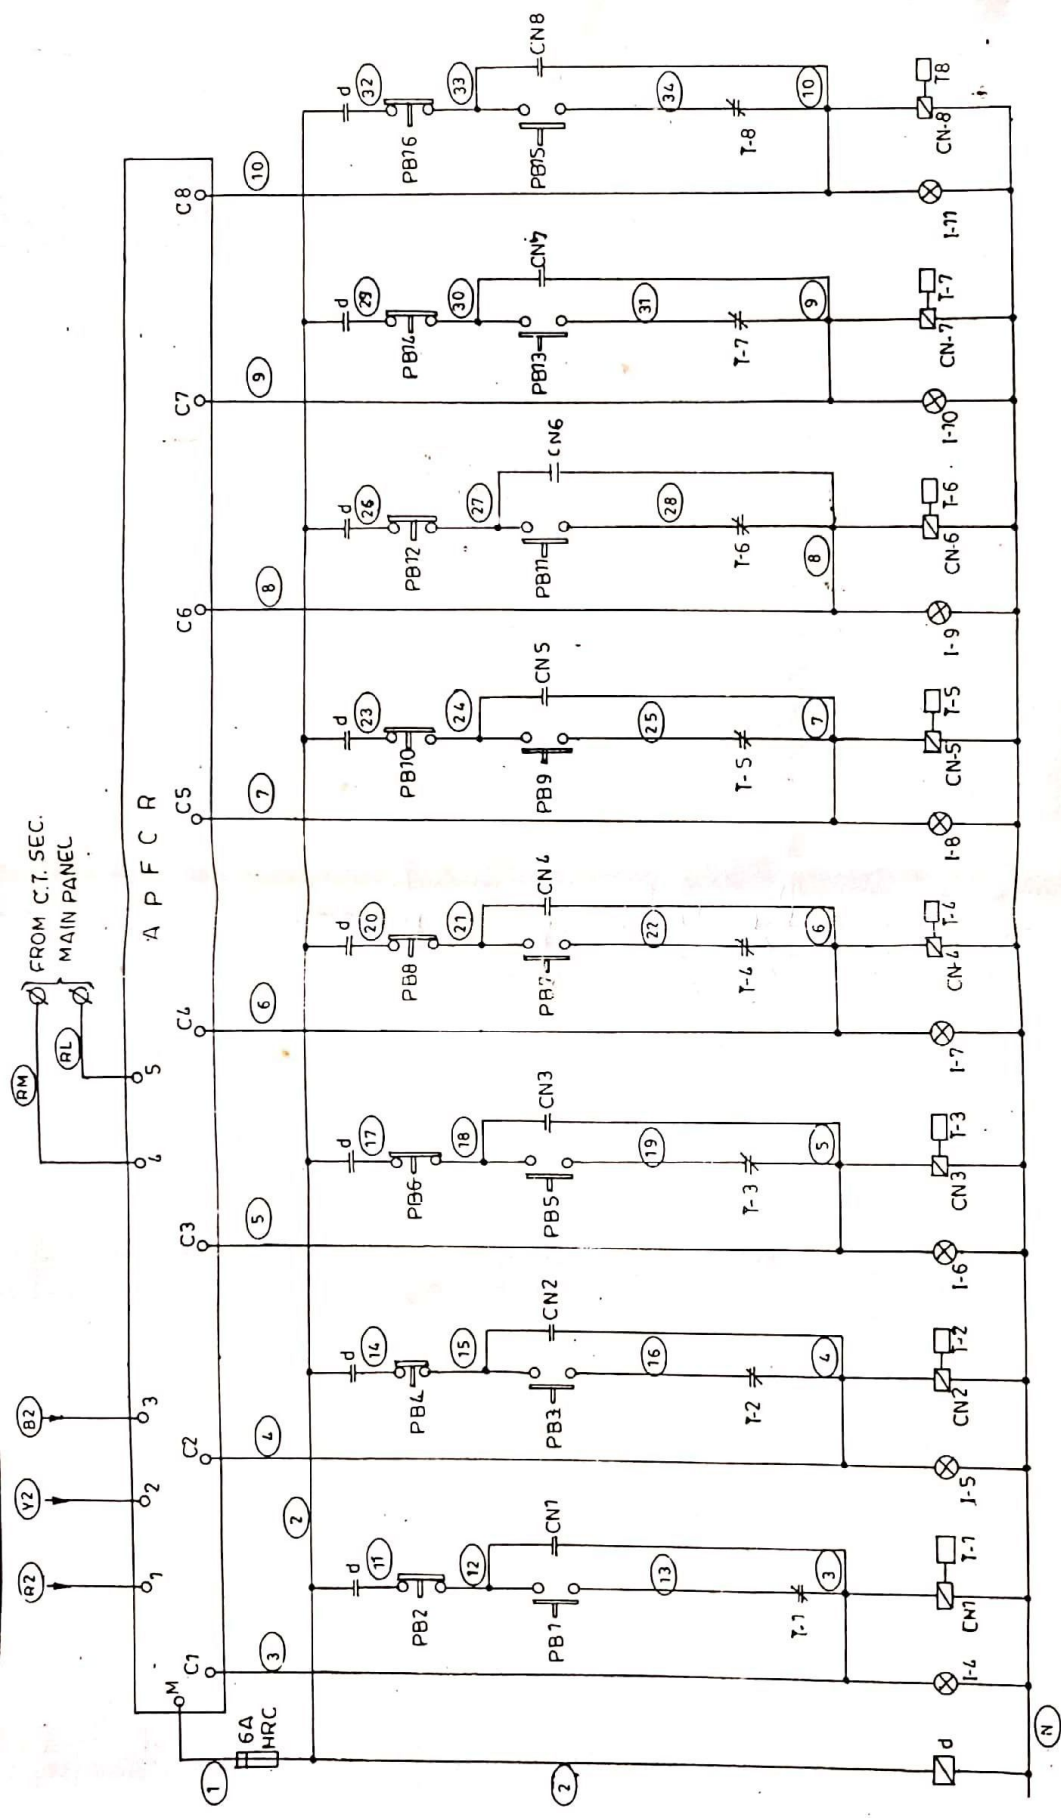


CAPACITOR PANEL


CONTROL SCHEMATIC **DRG. NO. - VE/11/00/0**

PROJECT **I. U. C. D. A. V. V., INDORE**


CONTRACTOR **M/S VIJENDRA ELECTRICALS, INDORE.**

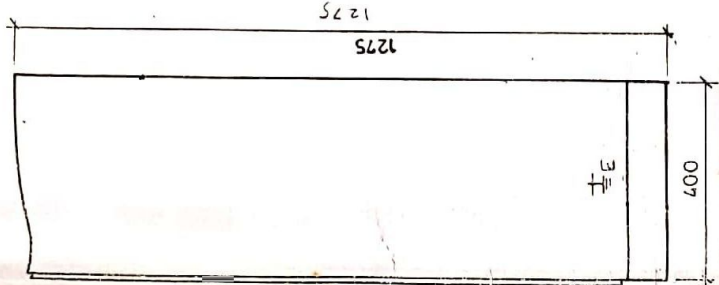

SIDE VIEW

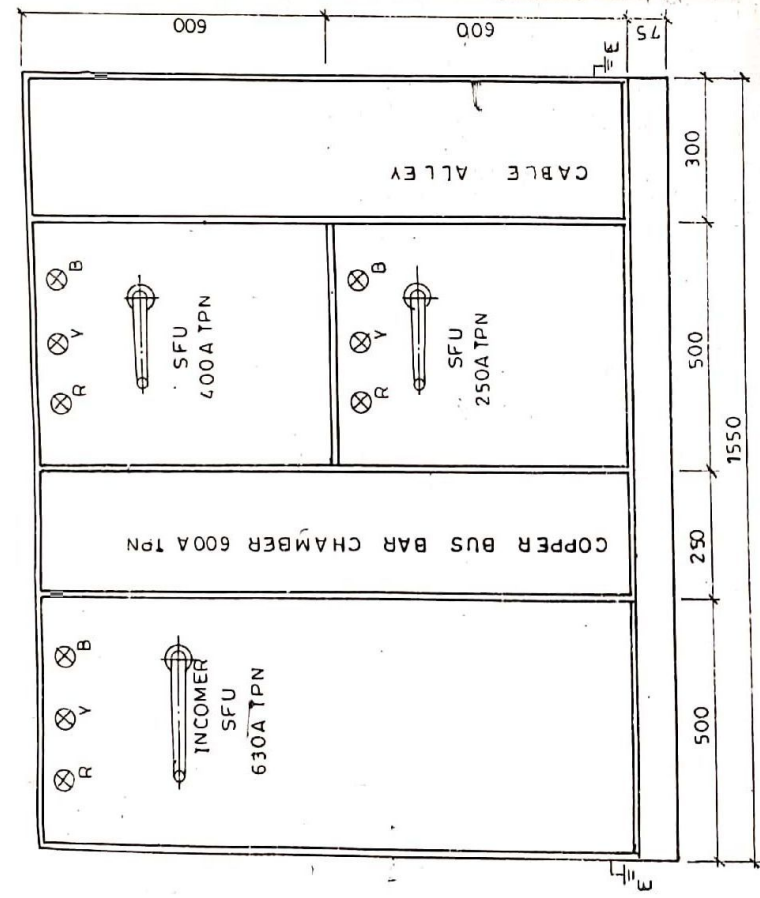


FRONT VIEW

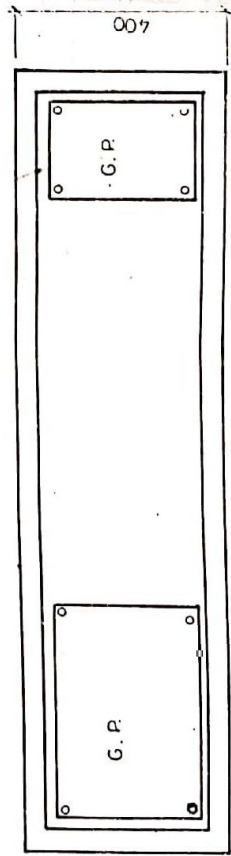

BOTTOM VIEW

SCALE - N.T.S.	DRG. NO. - VE/11/00/03
CRYOGENIC PANEL	G. A. DRAWING
DIMENSIONS IN MM.	SHEET - 16 SWG
COLOUR - LIGHT GREY	ELECTRICAL DISTRIBUTION
PROJECT T. U. C., D. A. V. V., INDORE	
CONTRACTORS M/s VIJENDRA ELECTRICALS, INDORE.	
MANUFACTURER HERTZ ELECTRONICS, INDORE.	

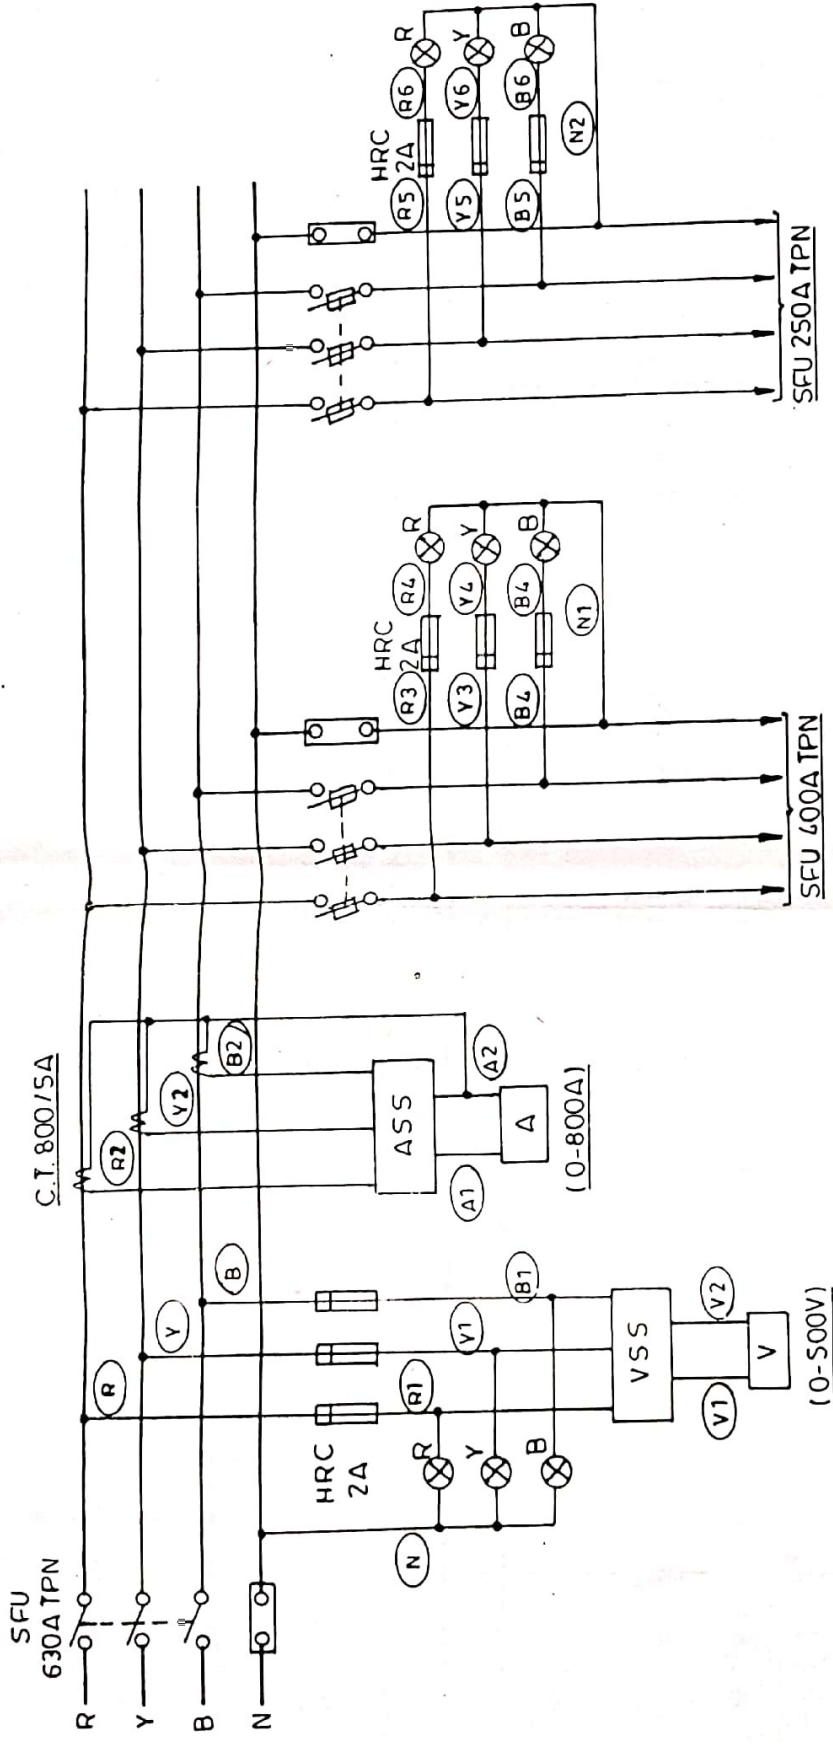


CRYOGENIC PANEL

POWER SCHEMATIC

DRG. NO. - VE/11/00/0


PROJECT I.U.C. D. A. V. INDORE

[Handwritten Signature]
 Engineer, IJC-PAE
 INDORE

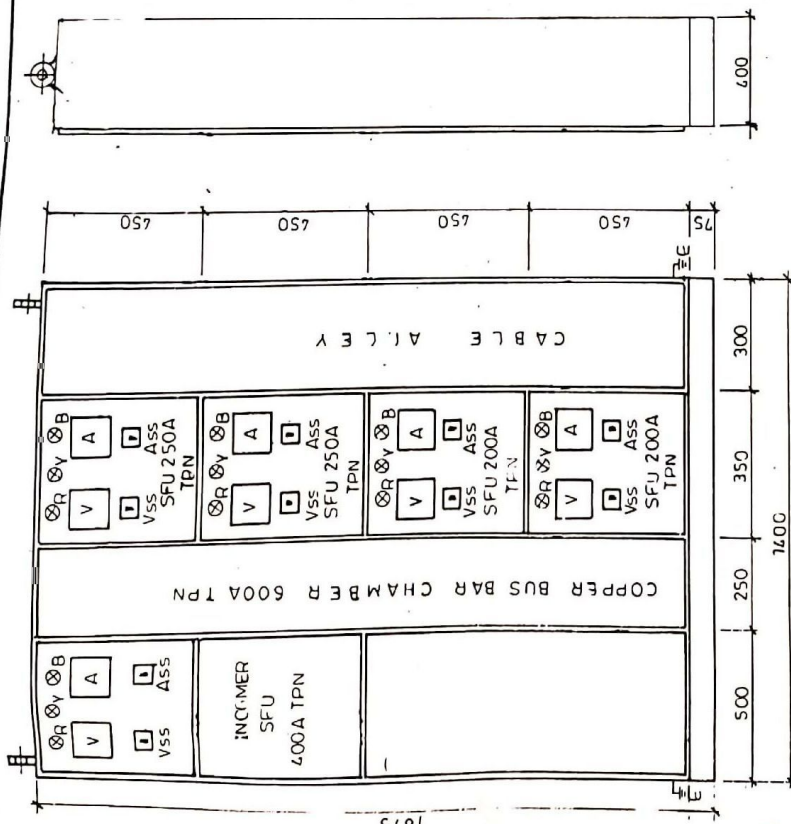


SIDE VIEW

FRONT VIEW

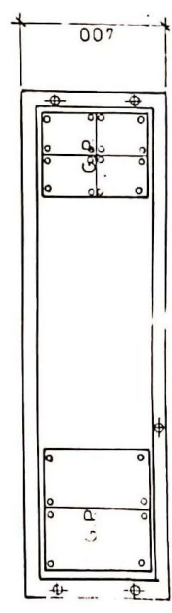


BOTTOM VIEW

SCALE - N.T.S.	DRG. NO - VE / 11/00/02A
He PLANT PANEL - I	G. A. DRAWING
DIMENSIONS IN MM	SHEET - 16 SWG
ELECTRICAL DISTRIBUTION PANEL	COLOUR - LIGHT GREY
PROJECT I.U.C., D.A.V.V., INDORE	
CONTRACTOR M/S VIJENDRA ELECTRICALS, INDORE.	
MANUFACTURER HERTZ ELECTRONICS, INDORE.	

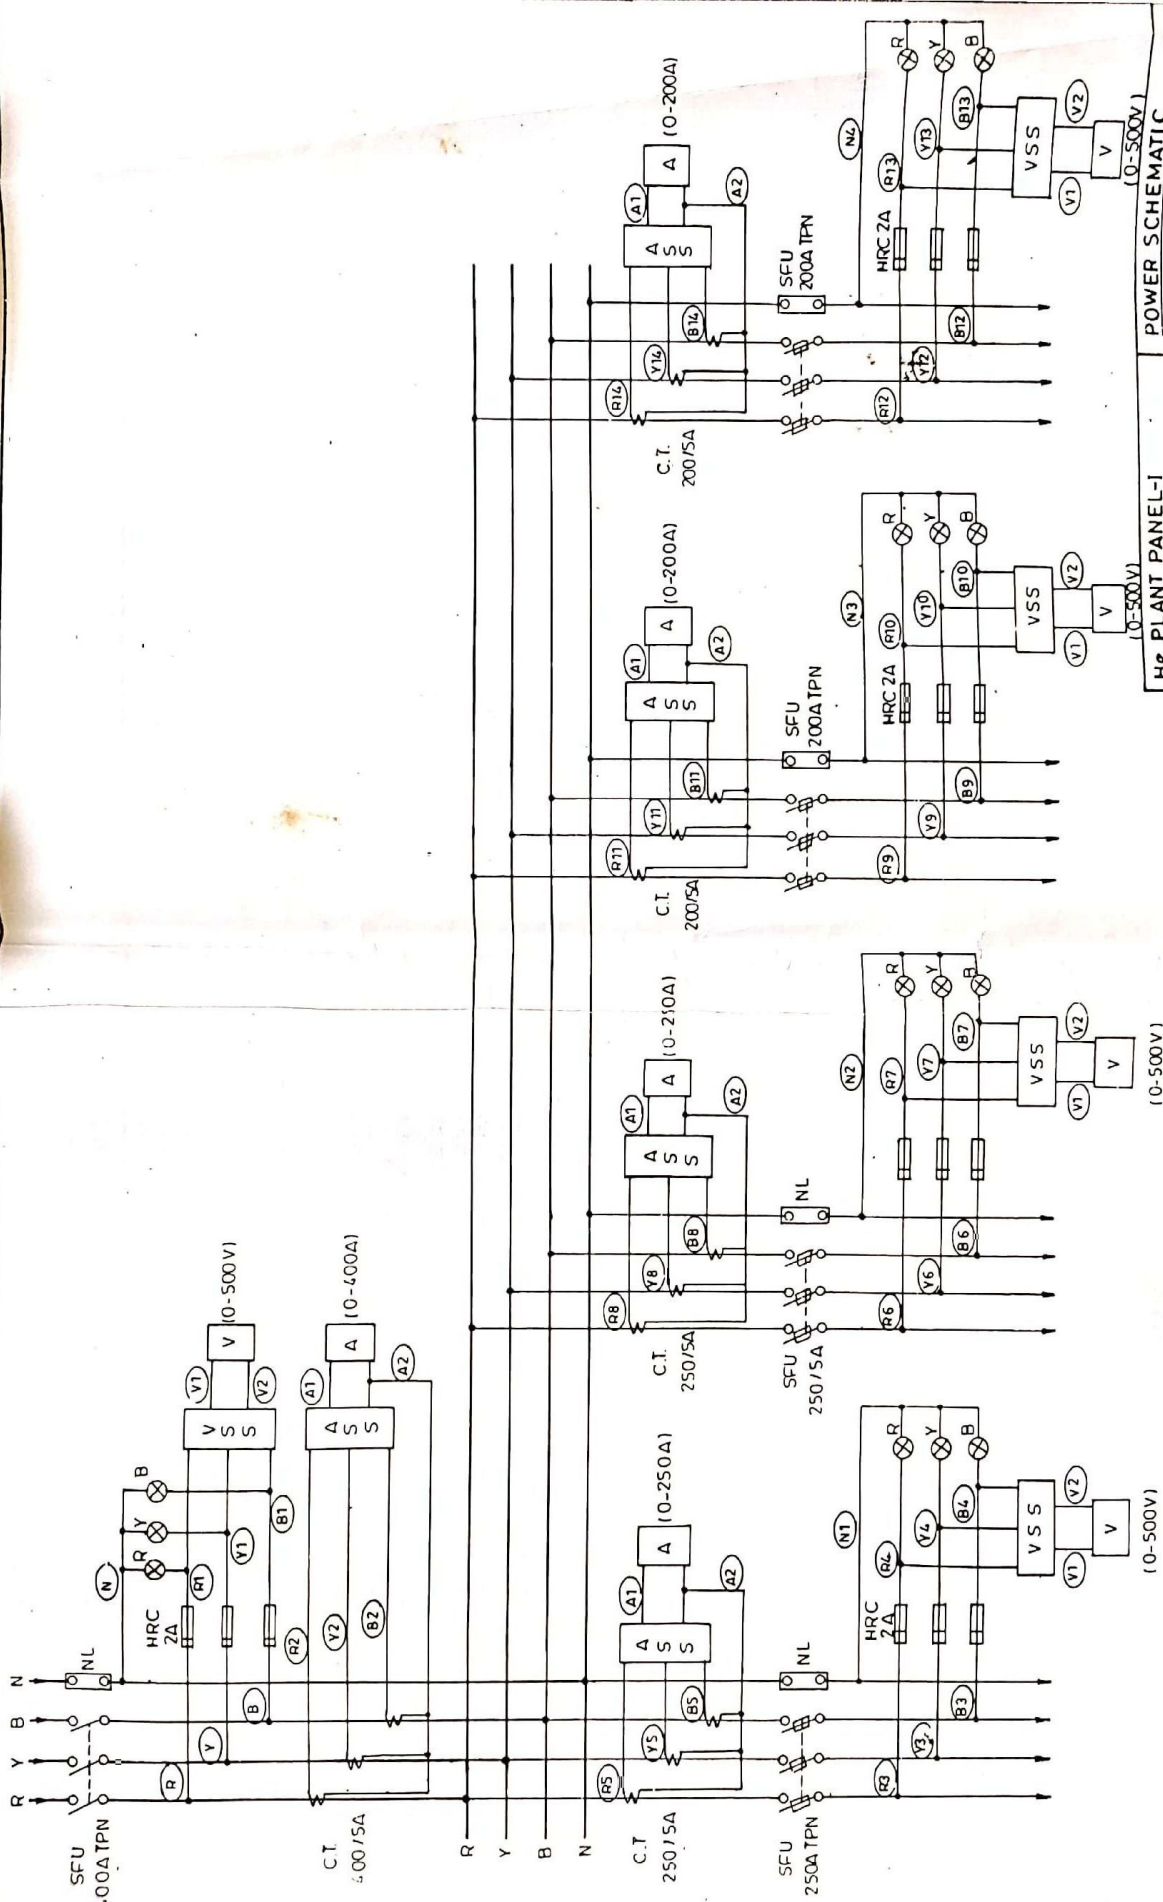

He PLANT PANEL-
DRG. NO - VE/11/00/0
PROJECT I.U.C.D.A.V.V. INDORE
CONTRACTOR M/s VIJENDRA ELECTRICALS, INDORE.
MFD. BY HERTZ ELECTRONICS, INDORE.


POWER SCHEMATIC
 (0-500V)
 (0-500V)
 (0-500V)
 (0-500V)

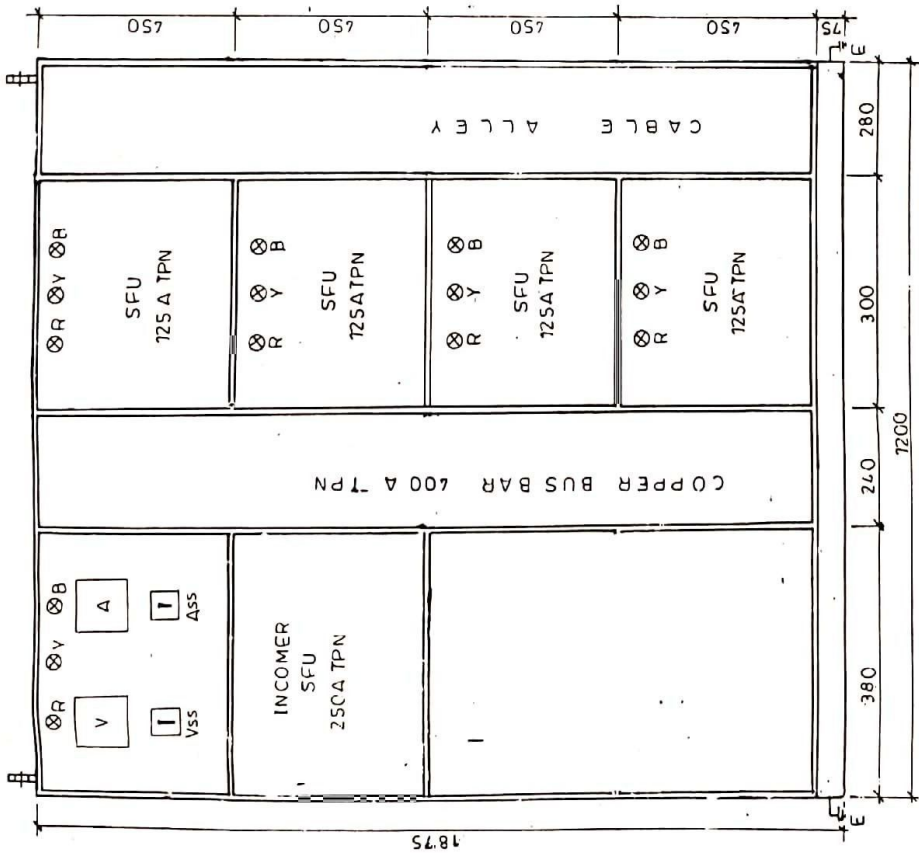

FRONT VIEW




SIDE VIEW

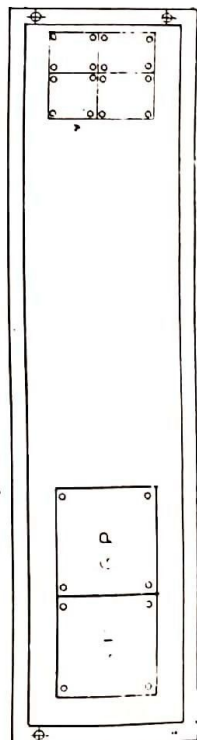

BOTTOM VIEW

ELECT. DISTRIBUTION PANEL	DRG. NO. - VE/11/00/02B
H2 PLANT PANEL - II	G. A. DRAWING
DIMENSIONS IN MM.	SHEET - 14/16 SWG.
COLOUR - LIGHT GREY	SCALE - N.T.S.
PROJECT I.U.C. D.A.V.V., INDORE.	
CONTRACTOR M/S VJENDRA ELECTRICALS, INDORE.	
MANUFACTURER HERTZ ELECTRONICS, INDORE.	

[Handwritten Signature]
 E.E.
 11/11/2005

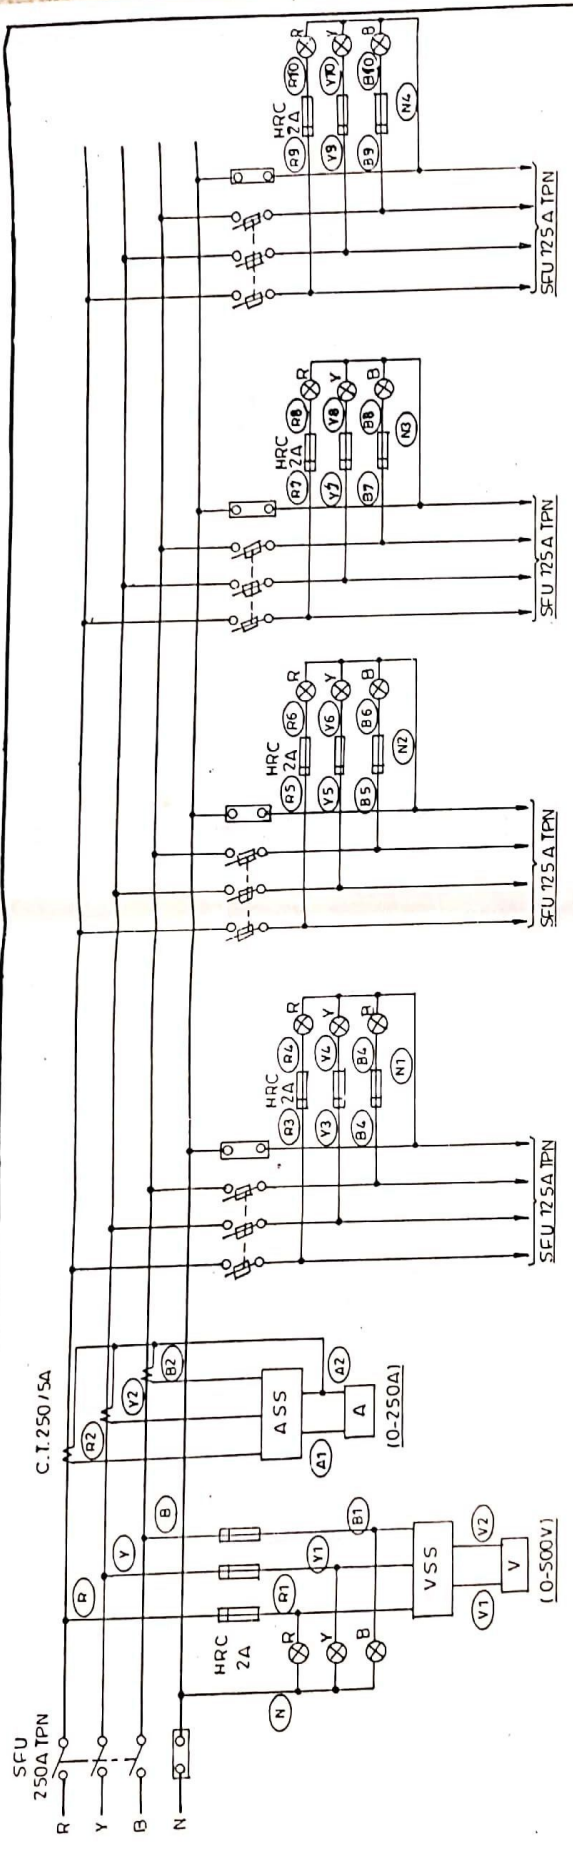


He PLANT PANEL-II

POWER SCHEMATIC DRG. NO. - VE / 11 / 00 / 0


PROJECT I. U. C. D. A. V. V., INDORE.

CONTRACTOR VIJENDRA ELECTRICALS, INDORE.


M.F.D. BY HERTZ ELECTRONICS, INDORE.

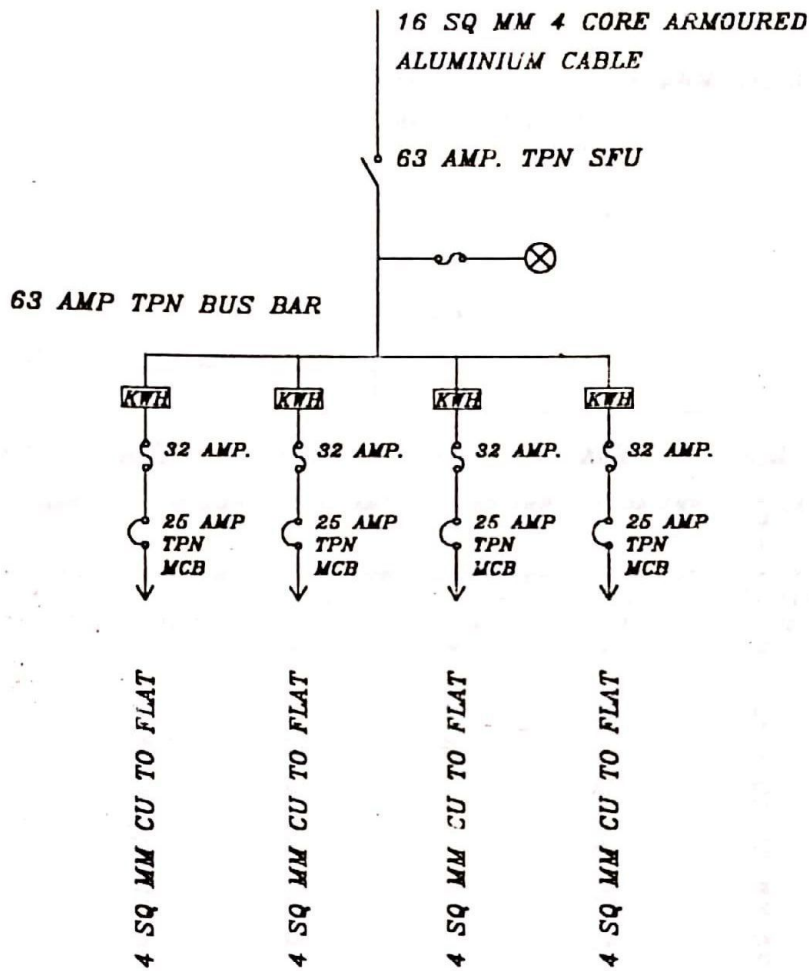

MAIN PANEL IUC "A" TYPE FLATS

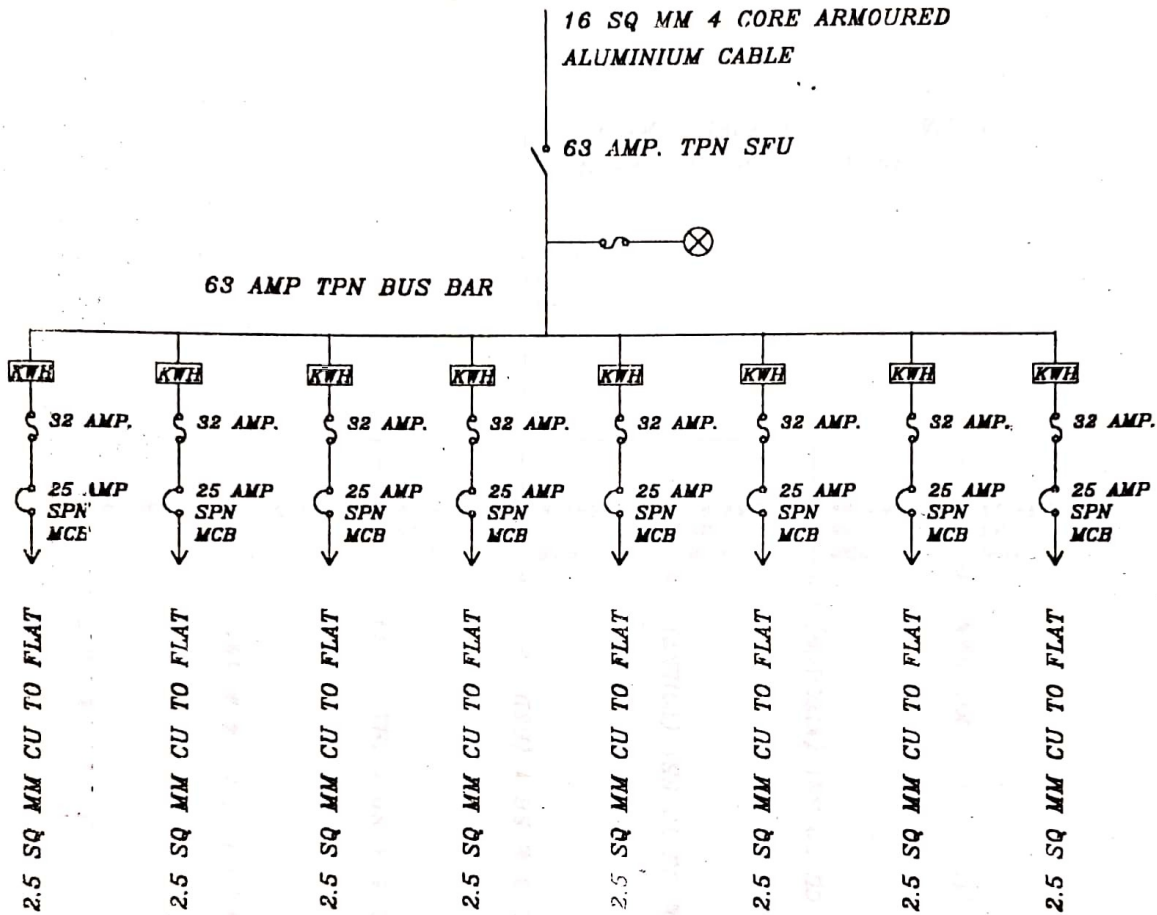

MAIN PANEL IUC "B" TYPE FLATS

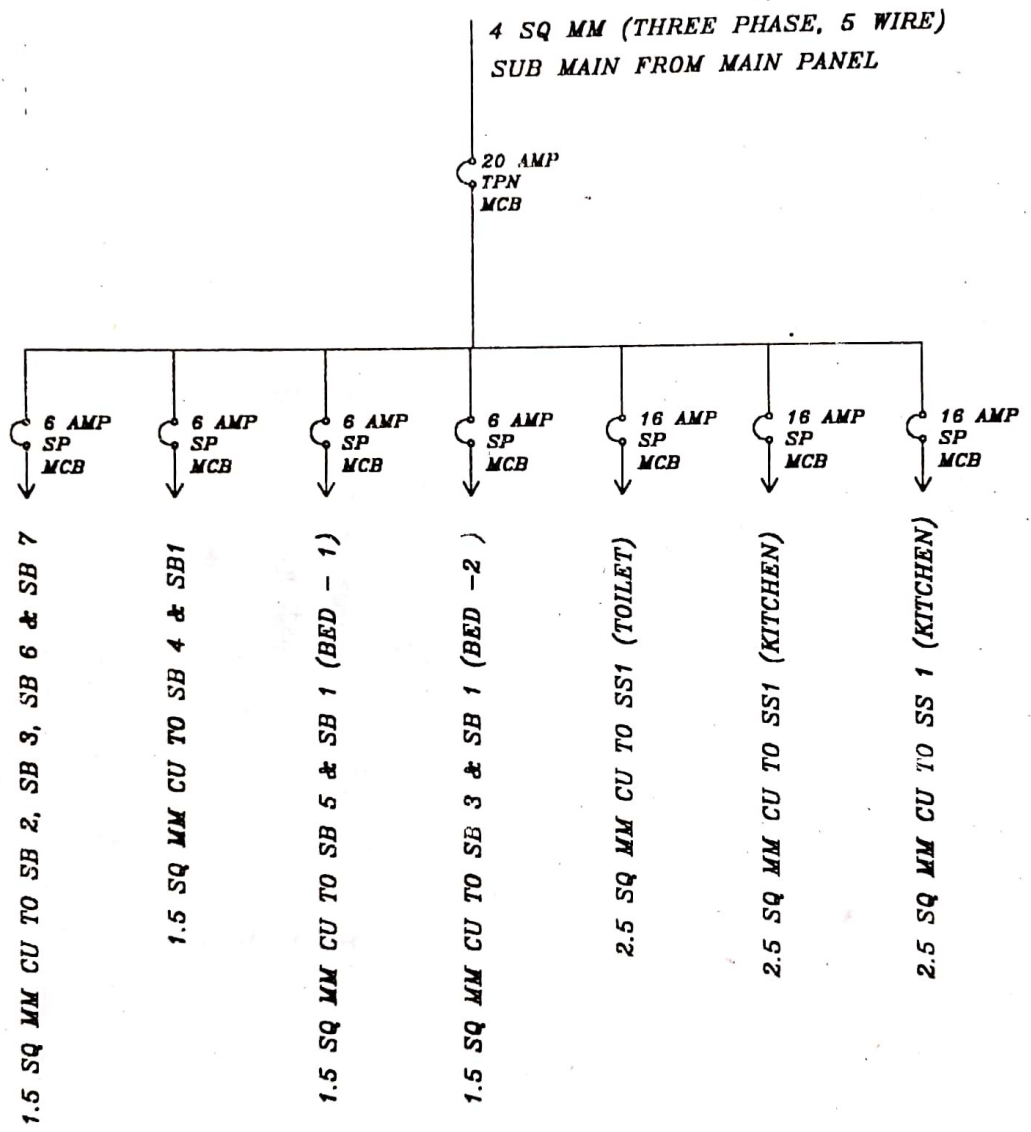

DISTRIBUTION DETAILS IUC "A" TYPE FLATS

TROUBLE SHOOTERS CONSULTING ELECTRICAL ENGINEERS
G-3, ARNIYA PLAZA, 27/2, MANORAMAGANJ, INDORE. PH 494284